

Name C. P. Moody

Service No. ~~125~~ 774

1253

Address R.F.D. #1, Concord, Mass.

844 EAST ST

Location 244 East Street,

Kind of Pipe

Size

Size of Main

Repair—Renewal—New Service

Location

Date
1941

Material

Amount

Total

Date

Amount

Dec. 5

2 hrs. @ 60¢

1 20

November 27, 1941

Deposited

24 00

Sum 12/29/41

10% Overhead

12

1 32

Dec 30, 1941

Refund

8 21

52' 3/4" Copper tubing @ 19¢

9 88

1 3/4" C. x 1/2" I.S. & W.

2 50

1 hr. trucking

75

Trench repairs

1 34

15 79

15 79

Labor

DATE 10.14.1941

TOWN OF LEXINGTON—BOARD OF PUBLIC WORKS

WATER DIVISION

The undersigned applies for a supply of water at No. 244 East St. St. and hereby agrees to comply with the rules and regulations as now, or at any future time, established by the Board of Selectmen.

Am't. of Estimate \$ 200.00

Owner Karl Axelson


Am't. Paid \$ _____

Address 244 East St

Builder C.P. Moody

Lexington

Sketch of Service Here

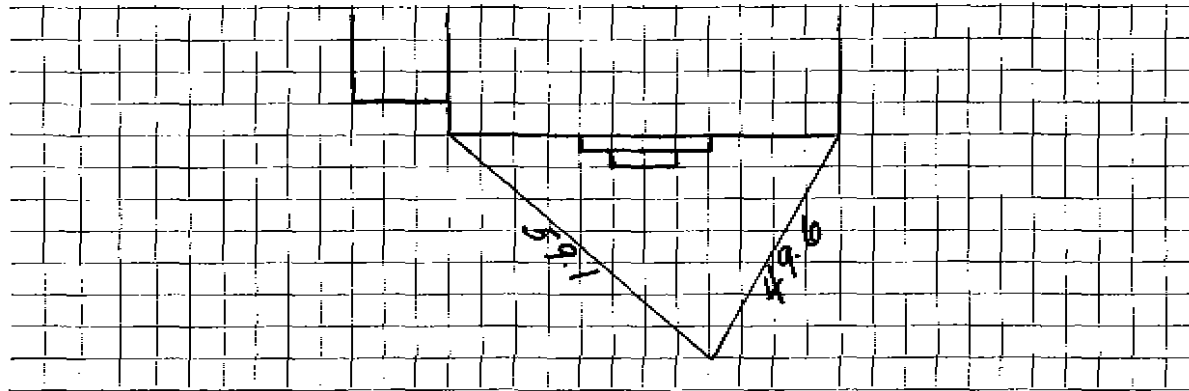

Connection made in _____ Street. Work completed _____ 19

Remarks: