

Name Northeastern Realty Trust

1302

Service No. 288

Address 247 East Street

Lexington, Mass.

Locatio 247 East Street

Kind of Pipe

Size

Size of Main

~~Repair Work~~ New Service

Com. 11-6-50

Location

Date	Material	Amount	Total	Date	Amount
Sept. 12, '50	Labor	4 69	4 69	Sept 12, '50	60 00
	10% Overhead		47		3 77
	70' - 3/4" Copper Tubing @.275	19 25			56 50
	1 - 3/4" C x 1/2" I.W.H. S&W	3 76			No Charge
	1 - 3/4" C x 3/4" C Union (3pts)	1 61		Sept. 12, '50	Labor
	Littlefield Shovel 1 hr. @ 7.00	7 00		23' - 3/4" Copper Tubing @.275	6 33
	Trucking 1 hr. @.75	75		1 - 3/4" C orp-cock	3 60
	Patching 19 x 3	19 00		1 - 3/4" C x 3/4" C Curb-cock	4 40
			56 53	1 - Box & Rod	3 35
				1 - 1/2" Offset Tail Piece	42
				1 - 1/2" Straight Tail Piece	42
				Littlefield Shovel 1 hr. @ 7.00	7 00
				Trucking 1 hr. @.75	75
	Labor				43 45

Hadley Press, Inc., Lexington

DATE _____

TOWN OF LEXINGTON—BOARD OF PUBLIC WORKS

WATER DIVISION

The undersigned applies for a supply of water at No. _____ St. and hereby agrees to comply with the rules and regulations as now, or at any future time, established by the Board of Selectmen.

Am't. of Estimate \$ _____


Owner _____

Am't. Paid \$ _____

Address _____

Builder _____

Sketch of Service Here

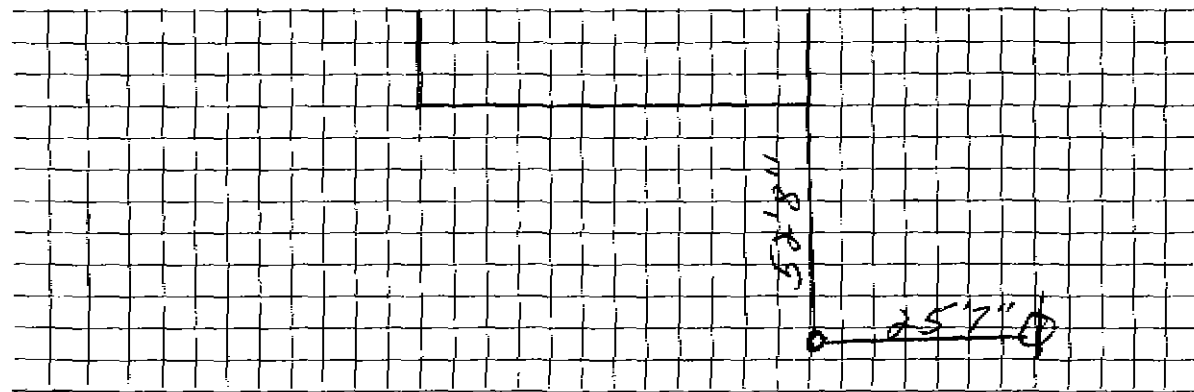

Connection made in _____ Street. Work completed _____ 19__

Remarks: