

Name Northeastern Realty Trust

Service No. 288

Address 249 East Street

Lexington, Mass.

Locatic 249 East Street

Kind of Pipe

Size

Size of Main

~~Repair - General~~ - New Service

Com. 11-6-50

Location

Date	Material	Amount	Total	Date	Location	Amount
Sept. 9, '50	Labor	4 69	4 69	Sept. 9, '50	Labor	5 00
	10% Overhead		47			
	60' - 3/4" Copper T.,bing @.275	16 50			23' - 3/4" Copper Tubing @.275	6 33
	1 - 3/4"C x 1/2" I.W.H. S&W	3 76			1 - 3/4"C Yorp-cock	3 60
	1 - 3/4"C x 3/4"C Union (3pts)	1 61			1 - 3/4"C x 3/4"C Curb-cock	4 40
	Littlefield Shovel 1 hr. @ 7.00	7 00			1 - Box & Rod	3 35
	Trucking 1 hr. @.75	75			1 - 1/2" Offset Tail Piece	42
	Patching 19 x 3		19 00		1 - 1/2" Straight Tail Piece	42
			53 78		Littlefield Shovel 1 hr. @ 7.00	7 00
					Trucking 1 hr. @.75	75
	Labor					31 27

Sub 1 50 Reported
11-7-50
 No Charge

60 00
 6 22
 53 78

Hadley Press, Inc., Lexington

DATE _____

TOWN OF LEXINGTON—BOARD OF PUBLIC WORKS

WATER DIVISION

The undersigned applies for a supply of water at No. _____ St. and hereby agrees to comply with the rules and regulations as now, or at any future time, established by the Board of Selectmen.

Am't. of Estimate \$ _____


Owner _____

Am't. Paid \$ _____

Address _____

Builder _____

Sketch of Service Here

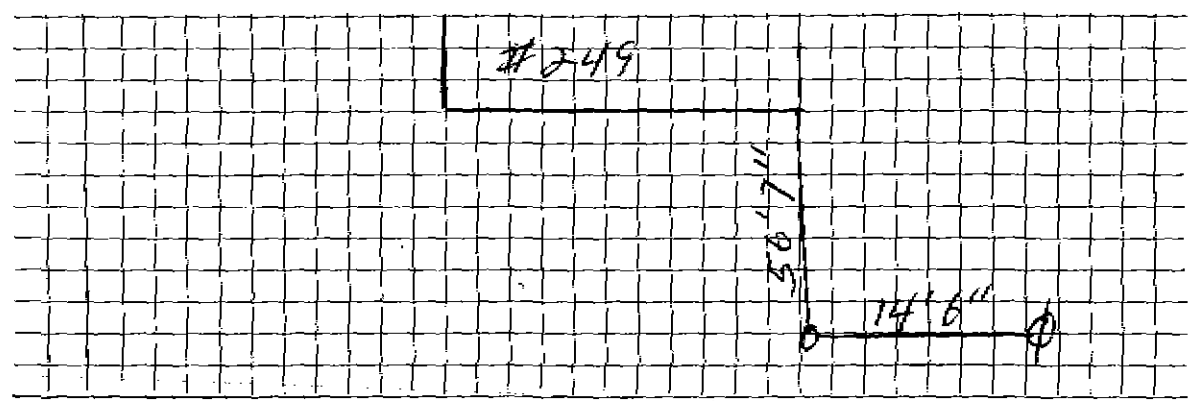

Connection made in _____ Street.

Work completed _____ 19

Remarks: