WATER SERVICE RECORD

4405

Service No.

Name

253 East Street


Address Location

Date	Material	Amount	Total	Date		Amount
				 		
 		 	 	 		
		 	 	 		
		 	 			
		 	 	-		
		<u> </u>		 		
		<u> </u>	 	∥		
		 	<u>'</u>	"		
		l	<u> </u>	<u> </u>		
· · · · · · · · · · · · · · · · · · ·		i !	ļ. -	ļ		
		i	 	<u> </u>		
		` <u> </u>		;; <u> </u>		
		<u> </u>	'\ 	" #	ļ	
	<u></u>)\ \{		
		 	ļ	 	-	
<u> </u>) 				
 -						<u> </u>
				- -	*	
			· _ 			

TOWN OF LEXINGTON - BOARD OF PUBLIC WORKS

WATER DIVISION

Sketch of Service Here

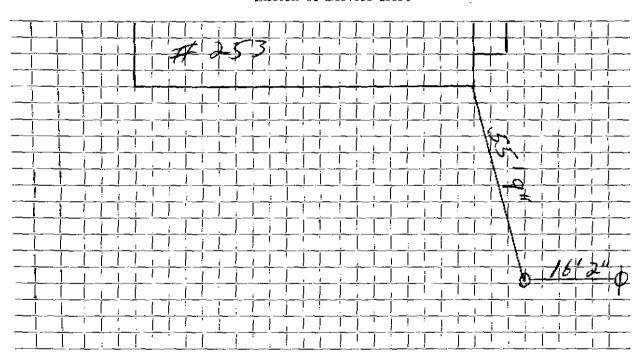

Connection made in Street.	Work completed
Remarks:	