

WATER SERVICE RECORD

Name

Service No.

Address 254 East Street

Location


Repair—Renewal—New Service

Date	Material	Amount	Total	Date	Amount
11/20/30	38' 1" C.L. Pipe				
	2 1" L.L. Coup				
	1 1" L.L. Ell				
	1 1" Br.Sp. Nipple				OUTSIDE - Renewal
	1 S & W			5/8/84	7' 3/4" Copper tubing
5/8/84	RENEWAL				1 3/4" Lead Adapter Med. Size
	1 1" L.L. Coupling				1 3/4" Curb
	6" x 1" C.L. Nipple				12 Yds. Gravel
	1 1" Style 38				

DATE 6/6/96

TOWN OF LEXINGTON — BOARD OF PUBLIC WORKS
WATER DIVISION

Sketch of Service Here

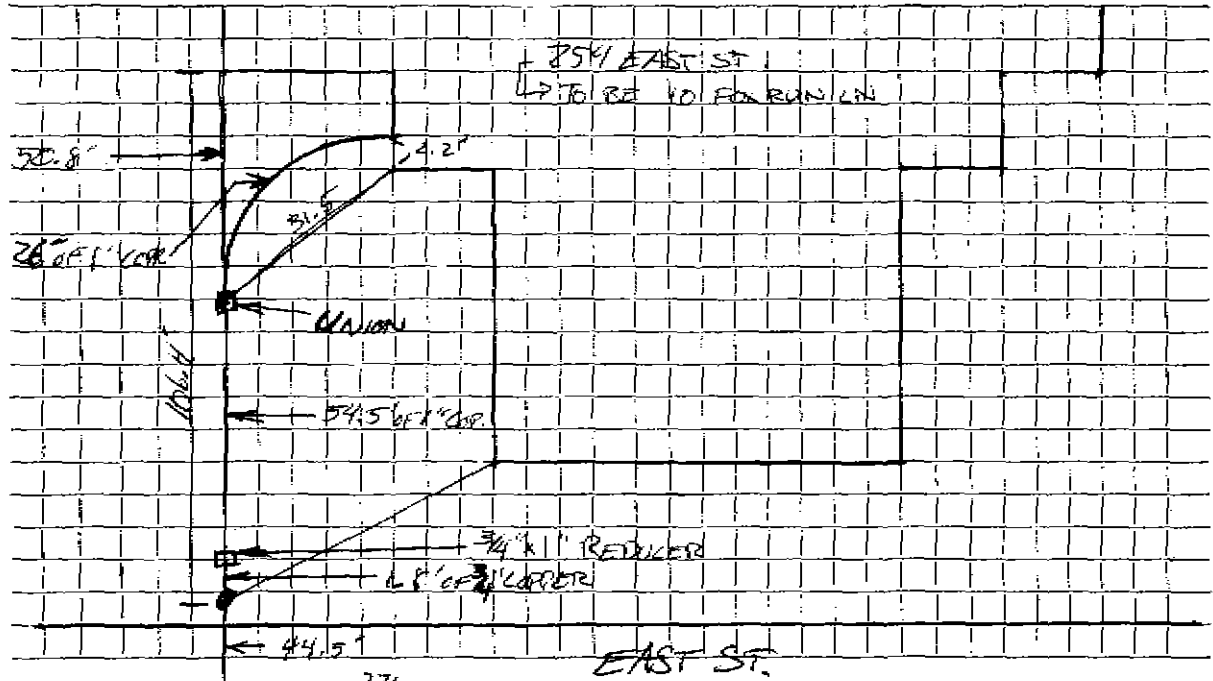

Connection made in POLE # 2745 Street. Work completed


Remarks:
.....
.....

DATE _____

TOWN OF LEXINGTON — BOARD OF PUBLIC WORKS

WATER DIVISION

Sketch of Service Here

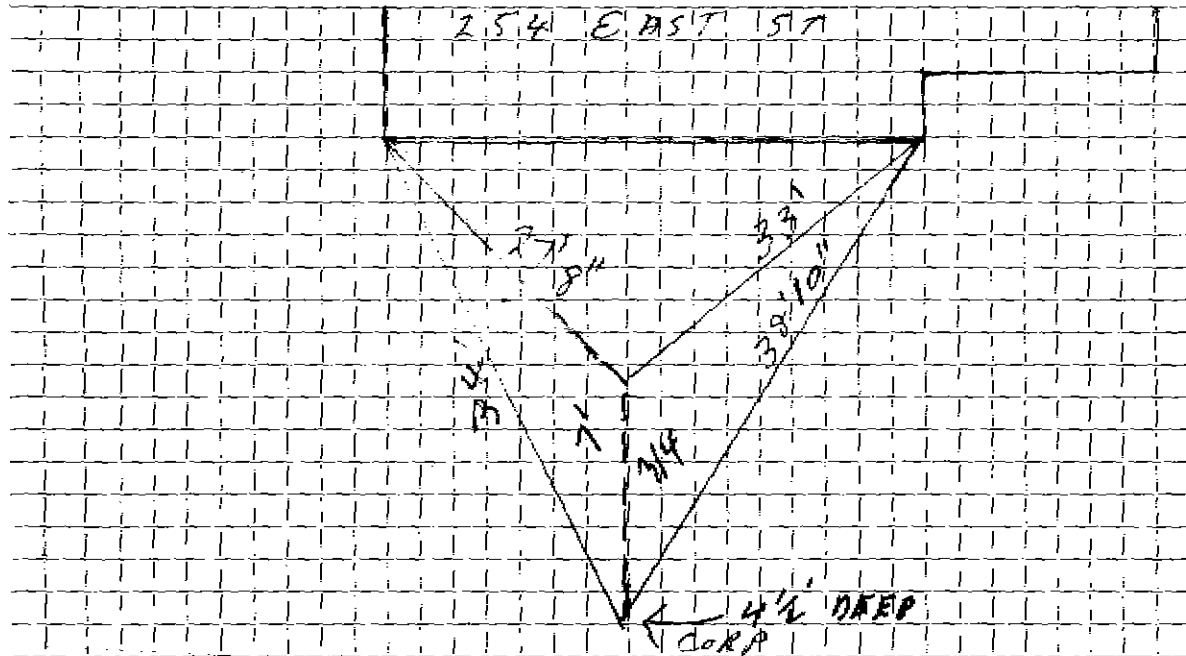

Connection made in Street. Work completed

Remarks:

.....

.....