

Name Northeastern Realty Trust

Service No. 288

Address 255 East Street

Lexington, Mass.

Locatic 255 East Street

Kind of Pipe

Size

Size of Main

~~Repair~~ New Service

Com. 11-6-50

Location

Date	Material	Amount	Total	Date	Location	Amount
Sept. 11, '50	Labor	4 69	4 69	Sept. 11, '50	Location	6 00
	10% Overhead		47			11
	53' - 3/4" Copper Tubing @.275		14 58		No Charge	0 00
	1 - 3/4" C x 1/2" I.W.H. S&W		3 76	Sept. 11, '50	Labor	19 68
	1 - 3/4" C x 3/4" C Union (3pts)		1 61	23' - 3/4" Copper Tubing @.275		6 33
	Littlefield Shovel 1 hr. @ 7.00		7 00	1 - 3/4" C Corp-cock		3 60
	Trucking 1 hr. @.75		75	1 - 3/4" C x 3/4" C Curb-cock		4 40
	Patching 19 x 3		19 00	1 - Box & Rod		3 35
			51 86	1 - 1/2" Offset Tail Piece		42
				1 - 1/2" Straight Tail Piece		42
				Littlefield Shovel 1 hr. @ 7.00		7 00
				Trucking 1 hr. @.75		75
	Labor					45 95

Hadley Press, Inc., Lexington

DATE _____

TOWN OF LEXINGTON - BOARD OF PUBLIC WORKS

WATER DIVISION

The undersigned applies for a supply of water at No. _____ St. and hereby agrees to comply with the rules and regulations as now, or at any future time, established by the Board of Selectmen.

Am't. of Estimate \$ _____


Owner _____

Am't. Paid \$ _____

Address _____

Builder _____

Sketch of Service Here

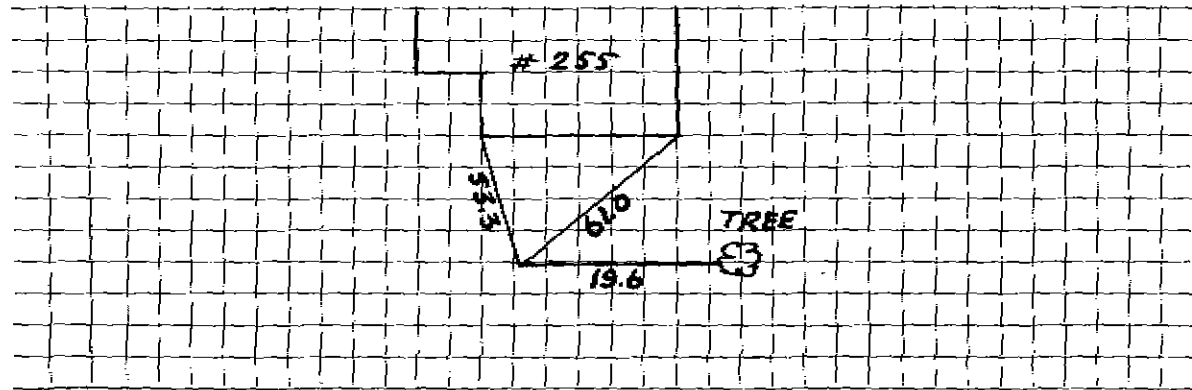

Connection made in _____ Street.

Work completed _____ 19

Remarks: