

WATER SERVICE RECORD

6155

Name Henry J. Moulton

Service No. 264

Address 260 East Street

Location Lexington, Mass.

Repair ~~Renewal~~ - New Service *Com 12-3-51*


Date	Material	Amount	Total	Date	Material	Amount
11/5/51	Labor	4 60	4 60	10-25-51	Deposited	45 10
	10% overhead		46	12-3-51	Deposited	48
	44' - 3/4" copper tubing @ .326		14 34		(credited to bal. due on 262 East St.)	2 37
	1 - 3/4" O x 1/2 I.W.H. stop & waste	4 00			NON CHARGE	42 15
	2 hrs. Littlefield shovel	7 14 00		11/5/51	Labor	4 60
	1 hr. trucking		75		6' - 3/4" copper tubing @ .326	1 95
	patching 4 x 3	4 00			1 - 3/4" C. corp-cock	4 53
		42 15			1 - 3/4" O x 3/4" C. curb-cock	4 67
					1 box and rod	4 68
					1 - 1/2 offset tail piece	50
					1 - 1/2 straight tail piece	50
					1 hr. Littlefield shovel	7 00
					1 hr. trucking	75
						28 98

DATE _____

TOWN OF LEXINGTON — BOARD OF PUBLIC WORKS

WATER DIVISION

Sketch of Service Here

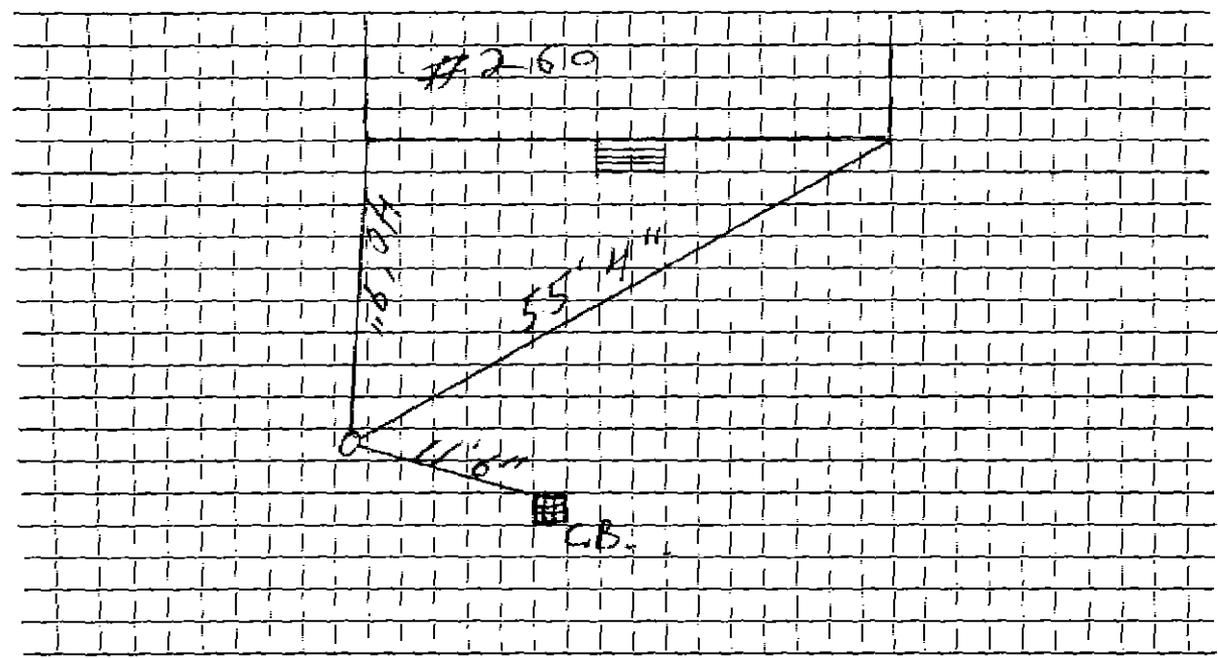

Connection made in Street. Work completed

Remarks:
.....
.....