

WATER SERVICE RECORD

839

Name Henry J. Moulton

Service No. 264

Address 262 East Street

Location Lexington, Mass.

~~Repair~~ ~~Renewal~~ New Service


262 East Street

| Date | Material | Amount | Total | Date | Amount |
|---------|-----------------------------------|--------|-------|----------|------------------------------------|
| 11/5/51 | Labor | 4 60 | 4 60 | 10-25-51 | Deposited 45 00 |
| | 10% overhead | | 46 | 10-3-51 | Paid (2 37) |
| | 60' -3/4" copper tubing @ .326 | 19 56 | | | <u>NON CHARGE</u> 47 37 |
| | 1 -3/4" Cx1/2 I.W.F. stop & waste | 4 00 | | 11/5/51 | Labor 4 60 |
| | 2 hrs. Littlefield shovel @ " | 14 00 | | | 5' -3/4" copper tubing @ .326 1 63 |
| | 1 hr. trucking | | 75 | | 1 - 3/4" C. corp-cock 4 33 |
| | hatching 4 x 3 | | 4 00 | | 1 - 3/4" C. curb-cock 4 67 |
| | | | 47 37 | | 1 - box and rod 4 68 |
| | | | | | 1 - 1/2 offset tail piece 50 |
| | | | | | 1 - 1/2 straight tail piece 50 |
| | | | | | 1 hr. Littlefield shovel 7 00 |
| | | | | | 1 hr. trucking 75 |
| | | | | | <u>28 66</u> |

DATE NOVEMBER 29, 1996

TOWN OF LEXINGTON — BOARD OF PUBLIC WORKS
WATER DIVISION

Sketch of Service Here

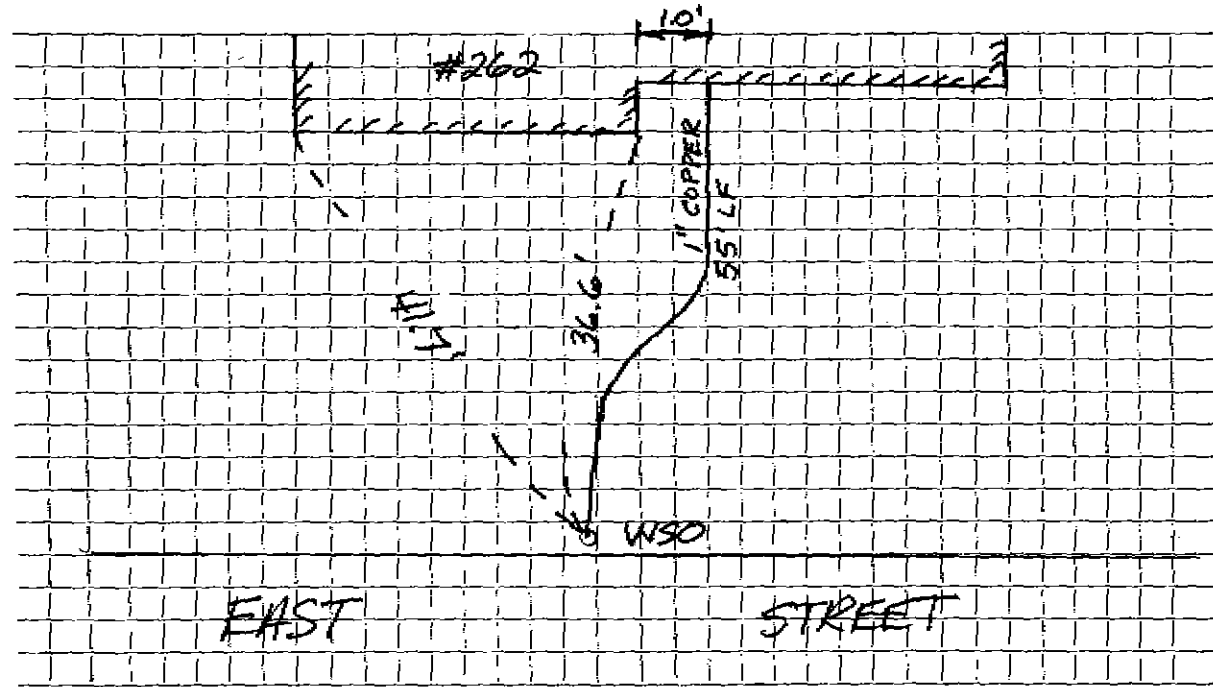

Connection made in EAST STREET Street. Work completed DAVID SANTO


Remarks:

DATE _____

TOWN OF LEXINGTON — BOARD OF PUBLIC WORKS

WATER DIVISION

Sketch of Service Here

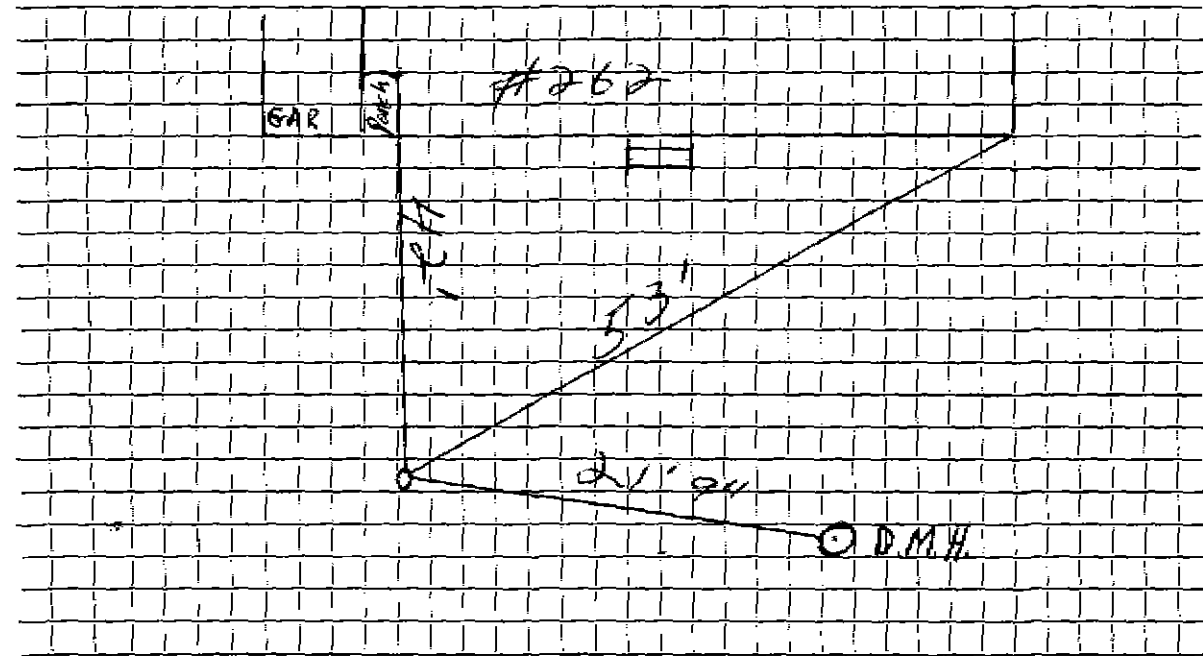

Connection made in Street. Work completed

Remarks:
.....
.....