

WATER SERVICE RECORD

Name Albert H. Burnham

Service No. 135

Address 34 East Street

Location

~~Repair - Renewal~~ - New Service

Comm. 9-3-57


Date	Material	Amount	Total	Date	Amount
7/15/57	Labor	19 51		7-15-57	Deposit
	10% overhead	1 95	21 46	9-3-57	Refund
	142' - 3/4" Copper tubing @ .4228	60 04			NON CHARGE
	1 - 3/4" Cx 1/2 I.W.H. Stop & Waste	4 96		1 - Box & Rod	4 62
	2 - C. Unions @ 2.27	4 54		1 - 3/4" C. Curb Cock	5 94
	35x3 Patch		35 00	1 - 1/2" Straight tailpiece	50
	2 hrs. Town Shovel @ 6.50		13 00	1 - 1/2" Offset tailpiece	50
	1 hr. Trucking		75		11 56
	1 hr. Rodgers Trailer		3 00		
	1 hr. Trucking		3 00		
			<u>145 75</u>		

DATE 3/8/59

TOWN OF LEXINGTON — BOARD OF PUBLIC WORKS

WATER DIVISION

Sketch of Service Here

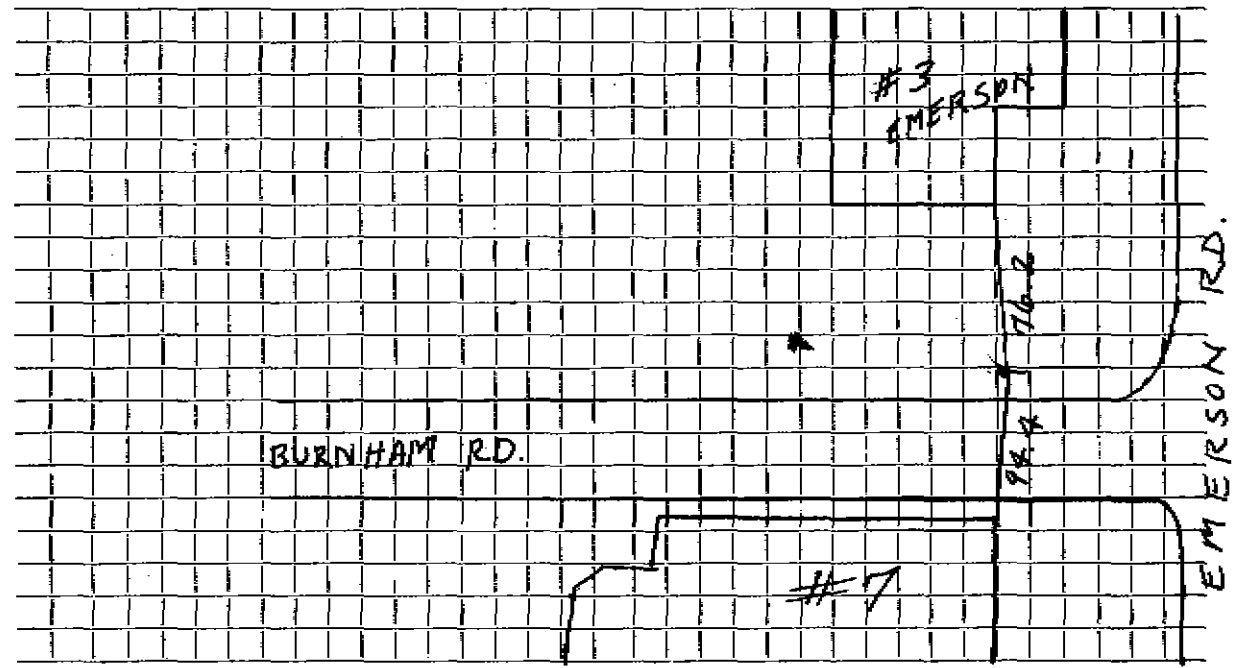

Connection made in BURNHAM RD. Street. Work completed

Remarks:
.....
.....