

WATER SERVICE RECORD

#5618
#5617

Name Mark Moore
Address 50 East Street
Location
Reason ~~Kennak~~ - New Service

Service No. 132

Comm. 9-3-57


Date	Material	Amount	Total	Date	Amount	
7/10/57	Labor	34 56		7-9-57	Deposit	\$ 100 00
	10%	3 46	38 02	9-25-57	Paid	8 83
	67' - 3/4" Copper tubing @ .4228	28 33			NON CHARGE	8 83 # 108 83
	1 - 3/4" C.x $\frac{1}{2}$ I.W.H. Stop & Waste	4 96			Labor	8 62
	1 hr. Trucking		75		41' - 3/4" Copper tubing @ .4228	17 33
	1 - 3/4" C. Union (3 part)		2 27		1 - 3/4" C. Corp Cock	4 64
	20x3 Patch		20 00		1 - 3/4" C/ Carb Cock	5 94
	2 hrs. Town Shovel @ 6.50		13 00		1 Box & Rod	4 62
	2 hrs. Trucking @ .75		1 50		1 - $\frac{1}{2}$ " Straight tailpiece	50
			108 83		1 - $\frac{1}{2}$ " Offset tailpiece	50
					1 hr. Town Shovel	6 50
					1 hr. Trucking	75
						49 40

Bill sent 9-5-57

DATE _____

TOWN OF LEXINGTON — BOARD OF PUBLIC WORKS
WATER DIVISION

Sketch of Service Here

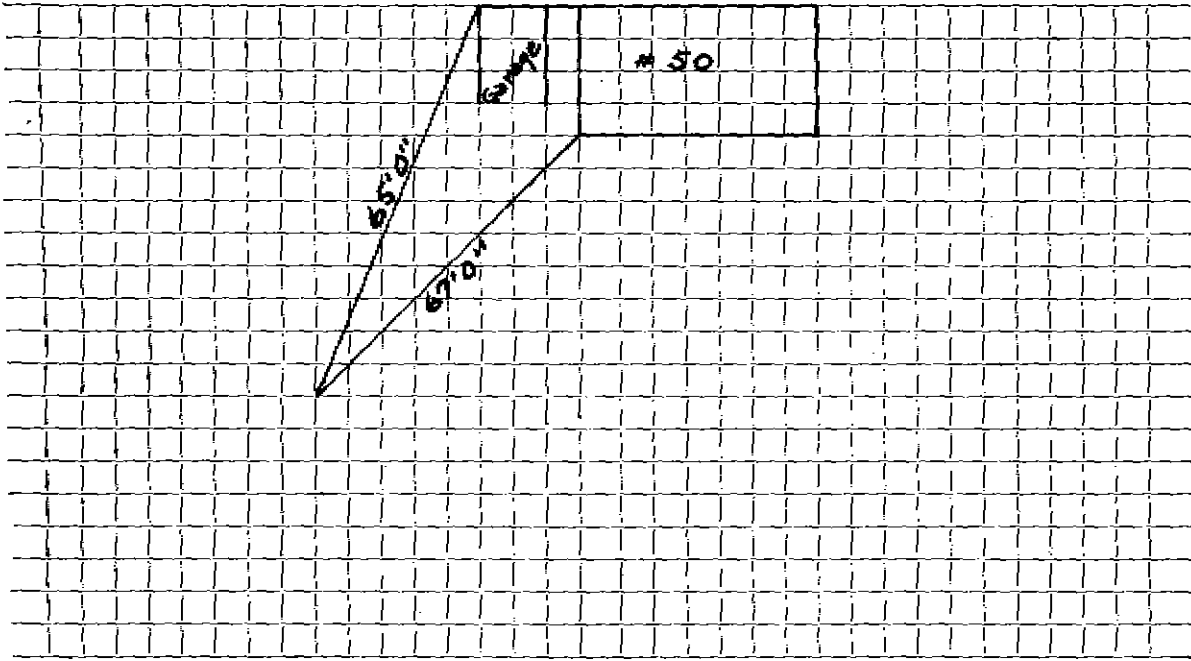

Connection made in Street. Work completed

Remarks:
.....
.....