

WATER SERVICE RECORD

Name Frances M. Baskin

Service No. 16

Address 61 East Street

Location

~~Repair Record~~ - New Service Dave Eagle #2281 W.O. #761

NOV 19 1973


| Date | Material | Amount | Total | Date | Amount |
|---------|-------------------------------|--------|--------|---------|--------------------------------|
| 5/11/73 | 48' 3/4" Copper tubing | | | 5-9-73 | 150.00 |
| | | | | 5-13-73 | 96.80 |
| 5/10/73 | Labor | 53.67 | | | 246.80 |
| | 10% O.H. | 5.37 | 59.04 | | |
| | | | | | OUTSIDE |
| | 17' 3/4" Copper @.60/Ft. | | 10.20 | 5/21/73 | 45.94 |
| | 1 3/4" Corporation | | 7.42 | 6 | hrs. Trucking @ 3.00/hr. 18.00 |
| | 1 3/4" Curb Cock | | 11.32 | 1 | hr. Roller @ 2.00/hr. 2.00 |
| | 1 Box and Rod | | 7.34 | 1 | hr. Trailer @ 1.00/hr. 1.00 |
| | 1/4 ton Cold Patch | | 2.10 | | TOTAL NON-CHARGE: \$ 66.94 |
| | Sidewalk Patch 5' x 8' | | 26.40 | | |
| | Street Patch 12' x 13' | | 103.98 | | |
| | 2 hrs. Trucking @ 3.00/hr. | | 6.00 | | |
| | 2 hrs. Town Shovel @ 6.50/hr. | | 13.00 | | |
| | TOTAL CHARGE: | | 246.80 | | |

DATE _____

TOWN OF LEXINGTON — BOARD OF PUBLIC WORKS

WATER DIVISION

Sketch of Service Here

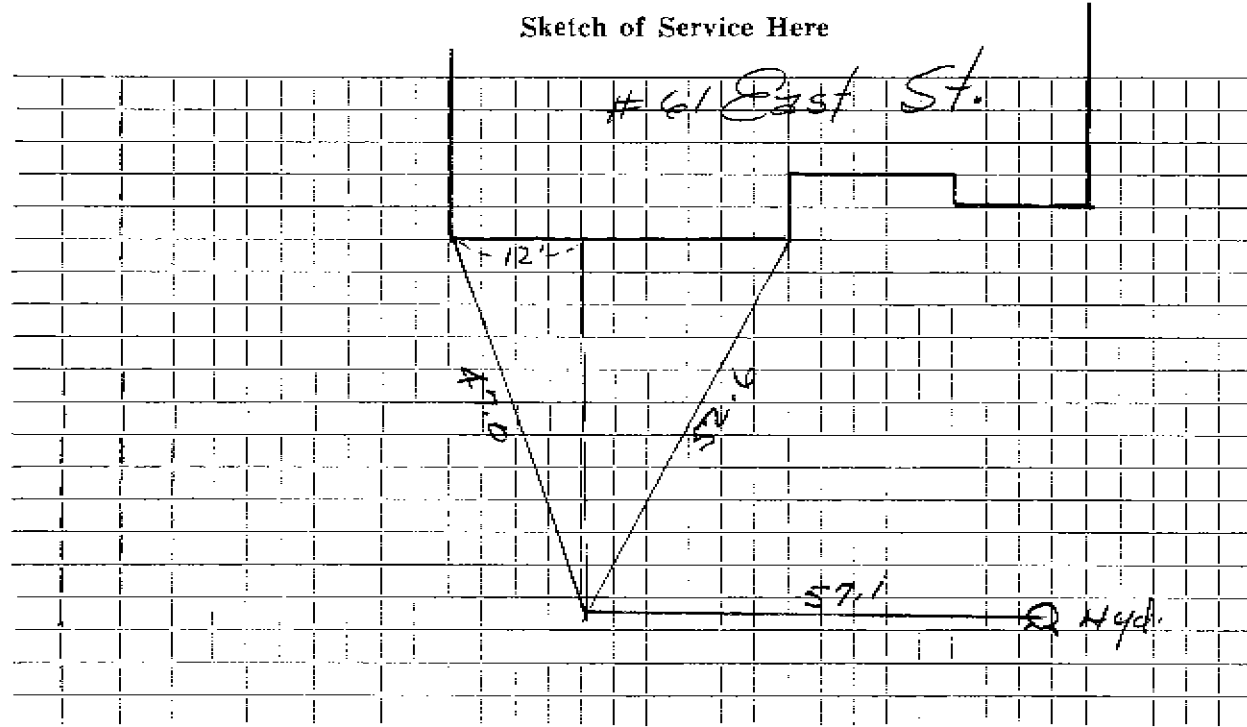

Connection made in Street. Work completed

Remarks:
.....
.....