

Name John L. Craig

Service No.

51-3123

Address 70 East Street

38

Lexington, Mass.

Location 70 East Street

Kind of Pipe

Size

Size of Main

~~Repair~~ ~~Renewal~~ ~~New Service~~

Com 9-16-46

Location

Date	Material	Amount	Total	Date	Location	Amount
May 30, '46	Labor	13.60	13.60	May 16, '46	Deposited	35.00
	10% Overhead		1.36	May 28, '46	and	4.89
	12' - 3/4" Copper Tubing @ .1315	3.15	3.36		Non-Charge	39.19
	1 - 3/4" C x 3/4" I.Y. Stop & waste	2.82	2.82	May 30, '46	Labor	29.57
	Patching 12 x 3		19.00		12' - 3/4" Copper Tubing @ .1315	4.17
	Trucking 1 hr. @ .75	.75	75		1 - 3/4" C. Corp-cock	2.70
			39.89		1 - 3/4" C. Curb-cock	3.30
					1 - Box & Rod	1.65
					1 - 3/4" Straight Tail Piece	.90
					1 - 2" Offset Tail Piece	.90
					Trucking 1 hr. @ .75	.75
						43.94
	Labor					

Hadley Press, Inc., Lexington

DATE _____

TOWN OF LEXINGTON—BOARD OF PUBLIC WORKS

WATER DIVISION

The undersigned applies for a supply of water at No. _____ St. and hereby agrees to comply with the rules and regulations as now, or at any future time, established by the Board of Selectmen.


Am't. of Estimate \$ _____

Owner _____

Am't. Paid \$ _____

Address _____

Builder _____

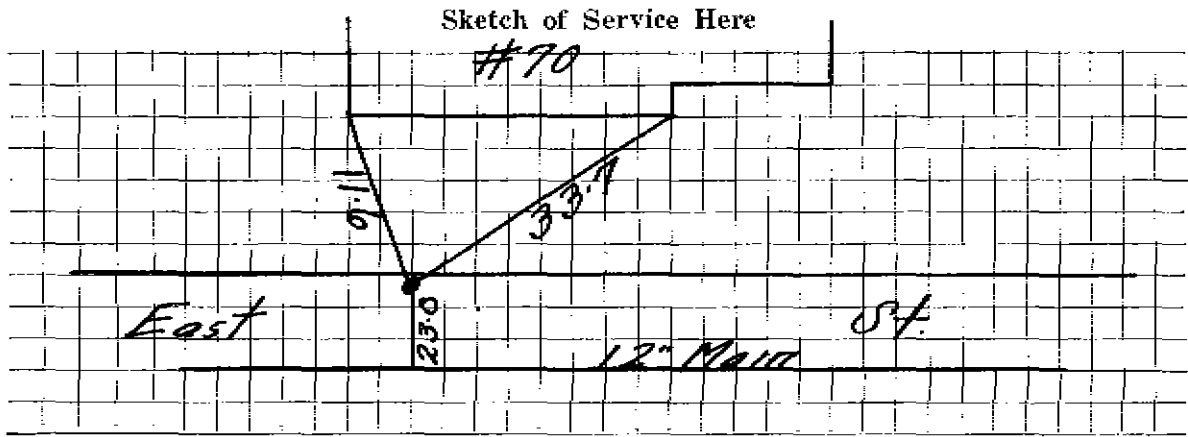

Connection made in _____ Street. Work completed _____ 19__

Remarks: