

Name William E. Fiske  
 Address 71 East Street,

Service No. ~~58~~ 764

# 4568

Location 71 East St.,

Kind of Pipe

Size

Size of Main

~~Repair~~ ~~Renewal~~ New Service

Location

Date 1943	Material	Amount	Total	Date	Amount
Nov. 12,	Labor	32 25		Nov 9, 1943	
Com 7/2/43	10% Overhead	3 23	35 48	Dec 10, 1943	
	83' 1" C.L. Pipe @ 23¢		19 09		
	2 1" L.L. Couplings @ 21¢		42		
	1" L.L. Union		37		
	1" L.L. Elbow		28		
	1" C.L. Pipe		15		
	1" x 3/4" F.F.S. & W.	2	53		
	1 3/4" x 5/8" Brass bushing		29		
	2 1/2" straight tailpieces @ 38¢		76		
	Trucking - 2 hrs. @ 75¢		1 50		
	Trench Repairs		2 00		
			63 17		
	Non-chargeable: Labor		70		
	8' 3/4" Copper tubing @ 21¢		1 68		
	1 3/4" " corp. cock		2 25		
	1 3/4" " curb cock		2 75		
	1 Box Labor		1 65		
			9 03		

*Deposited*  
*Returned*

100.00  
 36.83

Hadley Press, Inc., Lexington

DATE Nov 9, 1943

# TOWN OF LEXINGTON - BOARD OF PUBLIC WORKS

## WATER DIVISION

The undersigned applies for a supply of water at No. 71 East St. and hereby agrees to comply with the rules and regulations as now, or at any future time, established by the Board of Selectmen.


Am't. of Estimate \$ 100<sup>00</sup>

Owner Wm E Fiske  
*By Joseph H Fiske*

Am't. Paid \$ \_\_\_\_\_

Address 71 East St

Builder \_\_\_\_\_

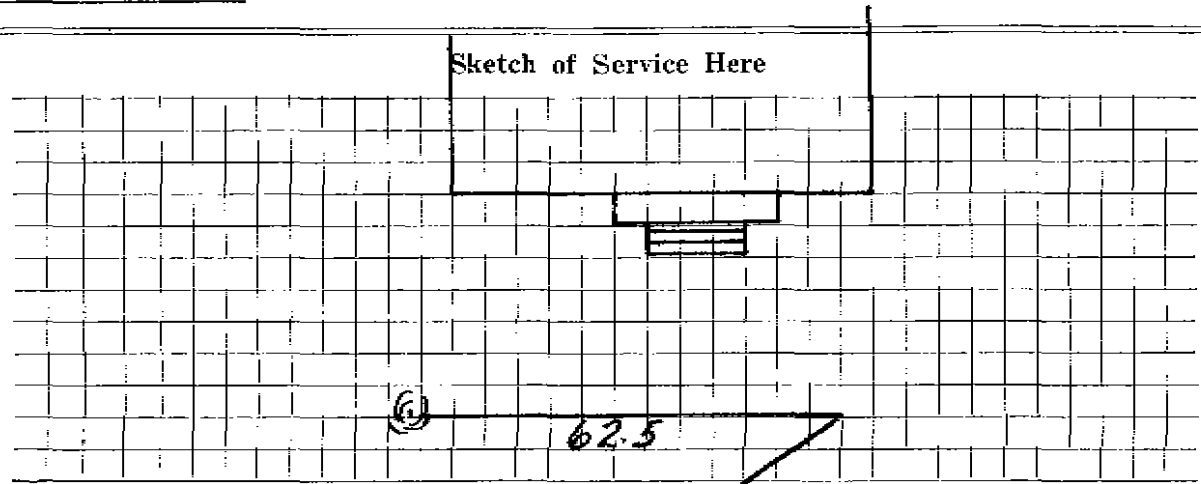

Connection made in \_\_\_\_\_ Street Work completed \_\_\_\_\_ 19

Remarks:

