

Name Winston H. Johnston

Service No. 268

Address 79 East Street

Lexington, Mass.

Location 79 East Street

Kind of Pipe

Size

Size of Main

~~Repair~~ ~~Renewal~~ New Service

Con. 3-6-50

Location

Date	Material	Amount	Total	Date	Amount
Jan. 17 '50	Labor	4 05		Dec. 29 '49	50 00
	10% Overhead	41	4 46	Mar 9 '50	17 39
	64'- 3/4" Copper Tubing @ .23		14 72		35 61
	1- 3/4"C x 1/2" I.W.H. S&W		3 29		
	1- 3/4"C x 3/4"C Union (3 pts)		1 39	Jan. 17 '50	
	1 hr. Littlefield Shovel		7 00		5 65
	1 hr. Trucking		75		10'- 3/4" Copper @ .23
	Patching 4 x 3		4 00		1- 3/4"C. Corp-cock
			35 61		1- 3/4"C. x 3/4"C. curb-cock
					1 Box & Rod
					1- 1/2" Offset Tail Piece
					1- 3/8" Straight Tail Piece
					1 hr. Littlefield Shovel
					1 hr. Trucking
	Labor				27 16

Deposited
Withdrawn

Non-Charge

TOWN OF LEXINGTON – BOARD OF PUBLIC WORKS

WATER DIVISION

The undersigned applies for a supply of water at No..... St. and hereby agrees to comply with the rules and regulations as now, or at any future time, established by the Board of Selectmen.

Am't of Estimate \$.....

Owner


Am't Paid \$.....

Address

Builder

.....

Sketch of Service Here

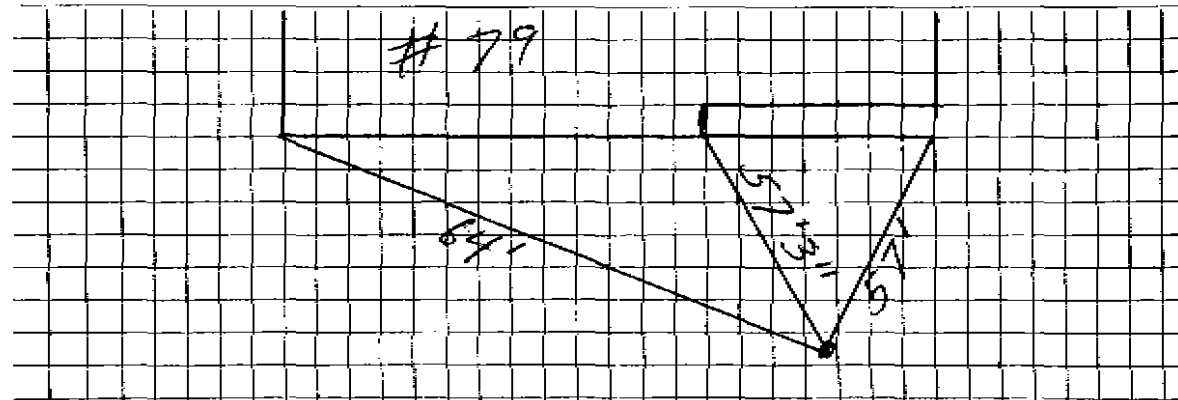

Connection made in Street.

Work completed19

Remarks: