

WATER SERVICE RECORD

Name

Service No.

Address 80 EAST ST

Location

Repair—Renewal—New Service Teardown J McLaughlin


Date	Material	Amount	Total	Date	EXIST	Amount
3/14/09	55' 1" COPPER				3/4 COPPER	
	1 3/4 x 1" INCR.				3/4 COPP	
	Buffalo box				3/4 CURB STOP	
				9-8-50	Outside:	
					34'-3/4 Cop	
					1-3/4 Corp	

DATE _____

TOWN OF LEXINGTON — BOARD OF PUBLIC WORKS

WATER DIVISION

Sketch of Service Here

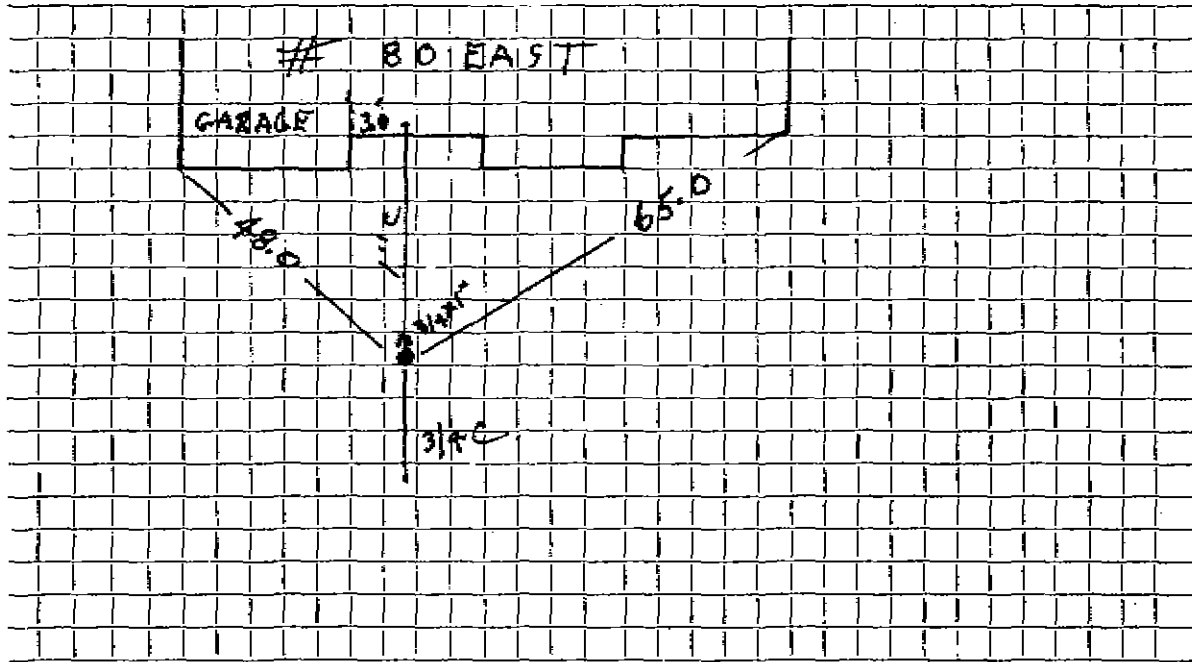

Connection made in Street. Work completed

Remarks:

.....

.....