




DATE \_\_\_\_\_

TOWN OF LEXINGTON — BOARD OF PUBLIC WORKS  
WATER DIVISION

Sketch of Service Here

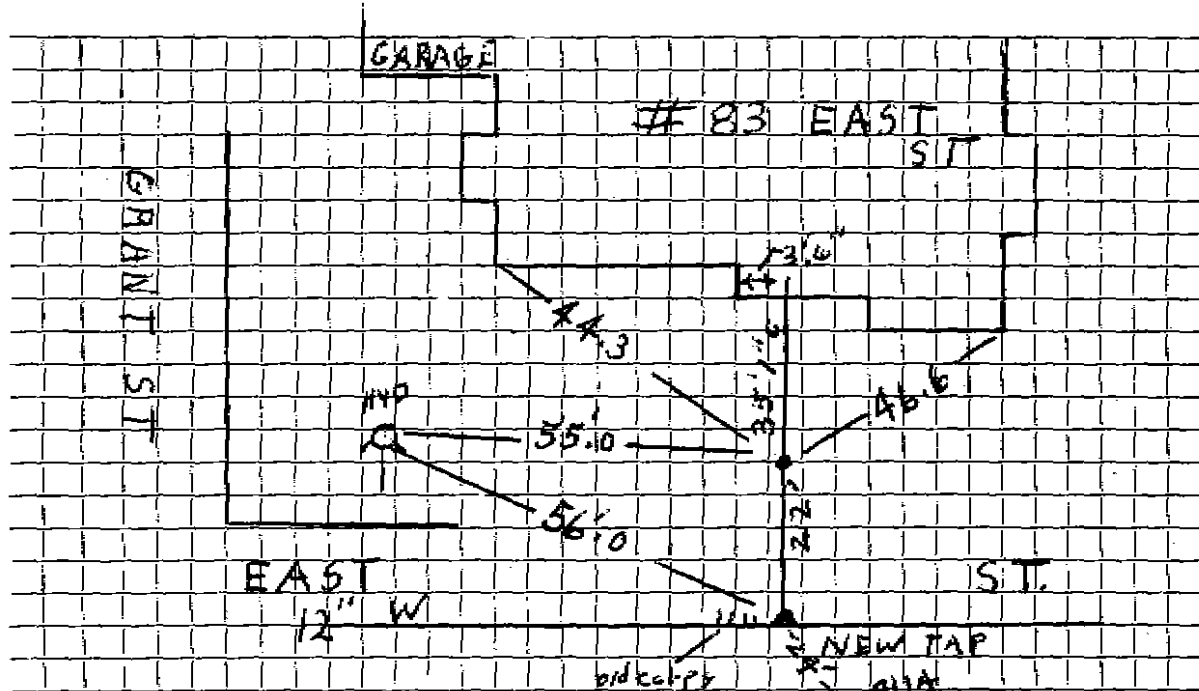

Connection made in \_\_\_\_\_ Street. Work completed NOV 2003

Remarks: *f. Way Branch Killed To Green house. IN Same Trench as New Serp.*