

WATER SERVICE RECORD

Name George T. O'Brien

Service No. 309

Address 99 East Street

Location

~~REPAIR WORK~~ - New Service


Com. 11-9-53

| Date | Material | Amount | Total | Date | Amount |
|---------|--------------------------------------|--------|-------|----------------|---------------------------------------|
| 10/1/53 | Labor | 5 17 | | <i>7-23-53</i> | <i>Deposited</i> 50 00 |
| | 10% overhead | 52 | 5 69 | <i>3-20-54</i> | <i>Paid</i> (7 06 |
| | 70' - 3/4" copper tubing@ .3629 | .3629 | 25 40 | | <u>NON CHARGE</u> 57 06 |
| | 1 - 3/4" C x 1/2 I.W.H. stop & waste | 4 00 | | 10/1/53 | Labor 10 00 |
| | 1 - 3/4" C x 3/4" C. union | 1 72 | | | 24' - 3/4" copper tubing@ .3629 8 71 |
| | 1 hr. Littlefield shovel | 7 50 | | | 1 - 3/4" C. corp-cock 4 33 |
| | 1 hr. trucking | 75 | | | 1 - 3/4" C x 3/4" C. curb-cock 4 67 |
| | patching 12 x 3 | | 12 00 | | 1 bar androd 3 90 |
| | | | 57 06 | | 1 - 1/2 straight tail piece 50 |
| | | | | | 1 - 1/2 offset tail piece 50 |
| | | | | | 2 hrs. Littlefield shovel@ 7.50 15 00 |
| | | | | | 1 hr. trucking 75 |
| | | | | | <u>48 36</u> |

Bill sent 11-9-53

WATER DIVISION

Sketch of Service Here

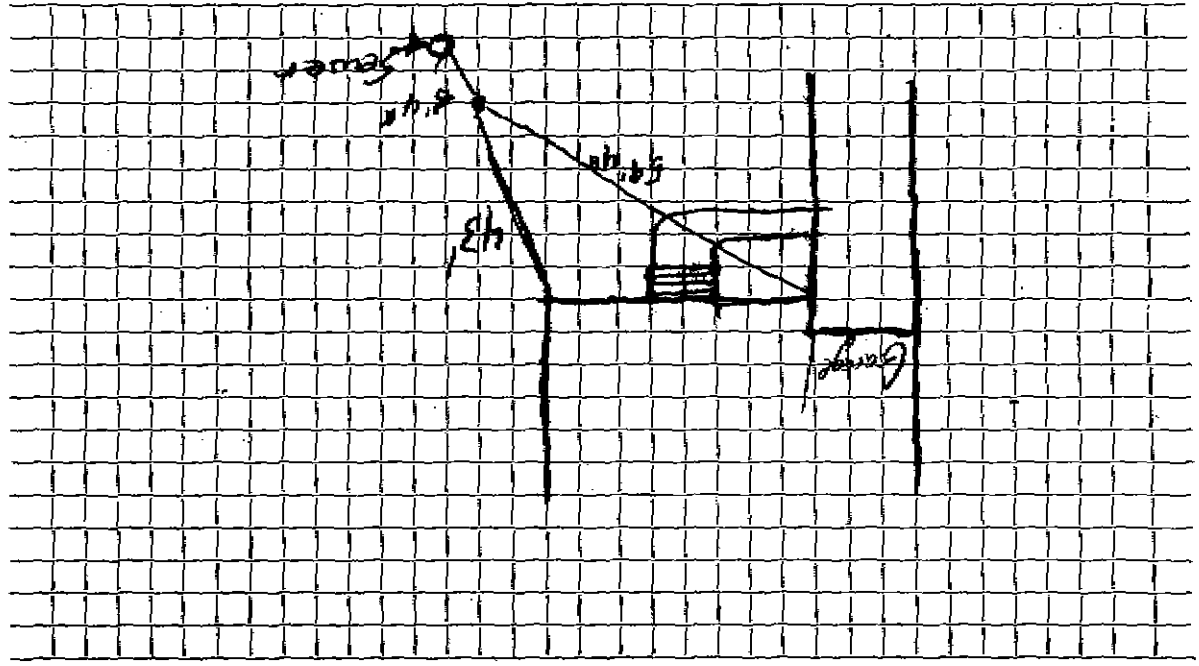

Connection made in

Street

Work completed

Remarks:

.....
.....
.....