

WATER SERVICE RECORD

Name John M. Lucente

Service No. 48

Address East Street @ Frost Road

Location

Repair—Renewal—New Service TAPPING SLEEVE & GATE W.O. #8017

Comm 10-28-63

Date	Material	Amount	Total	Date	Amount
6-18-63	Labor	113.22		6-11-63	Deposit 100 00
	10% O.H.	11.32	124.54	12-19-63	Paid 68 14
	10 lbs. Leadite @.12		3.60		168 14
	3 ton Patch @5.00		15.00		
	2 hrs. Town Shovel @6.50		13.00		
	3 hrs. Trucking @3.00		9.00		
	1 hr. Trailer @3.00		3.00		
			168.14		


Bill sent 12-19-63

DATE _____

TOWN OF LEXINGTON — BOARD OF PUBLIC WORKS

WATER DIVISION

Sketch of Service Here

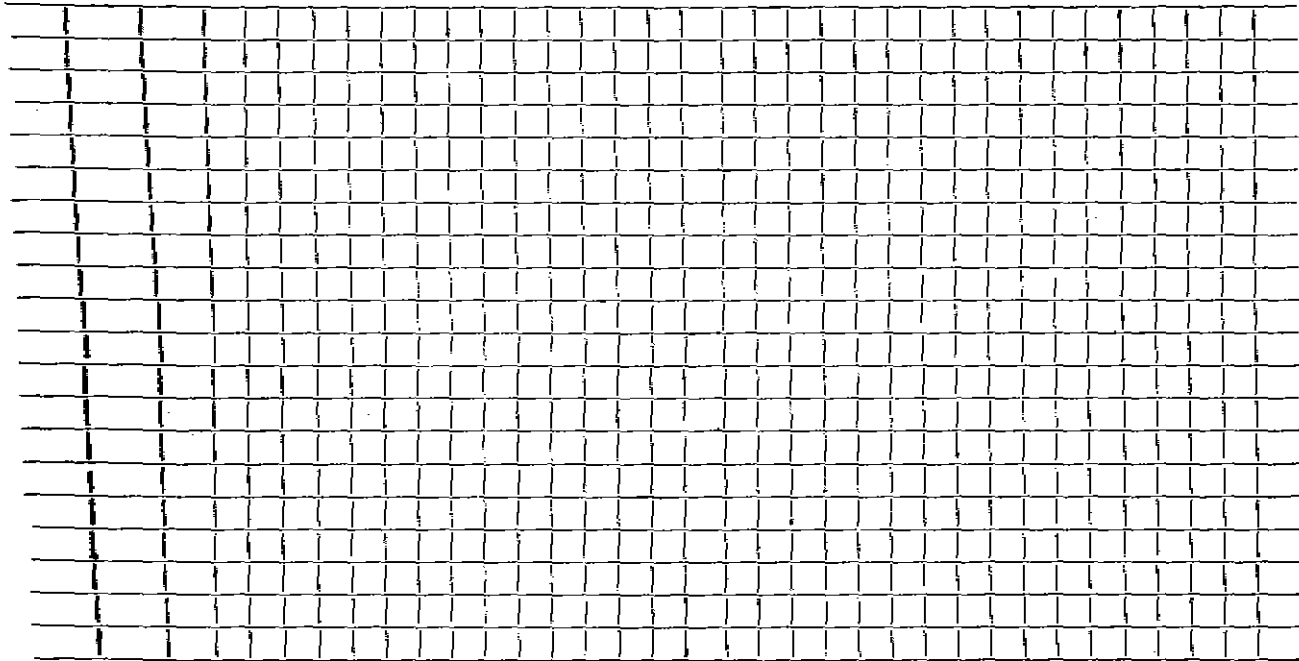

Connection made in Street. Work completed

Remarks:
.....
.....