


DATE _____

TOWN OF LEXINGTON — BOARD OF PUBLIC WORKS
WATER DIVISION

Sketch of Service Here

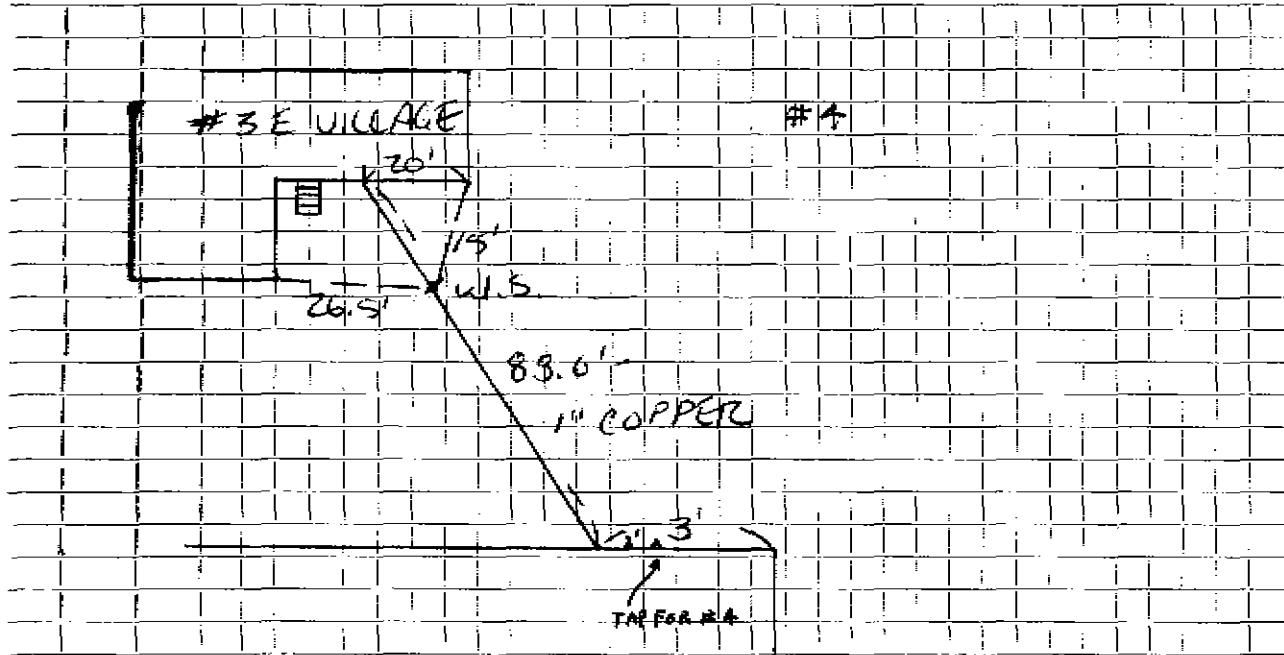

Connection made in SPENCER Street. Work completed 4-7-76

Remarks:

.....

.....