


TOWN OF LEXINGTON — BOARD OF PUBLIC WORKS
WATER DIVISION

Sketch of Service Here

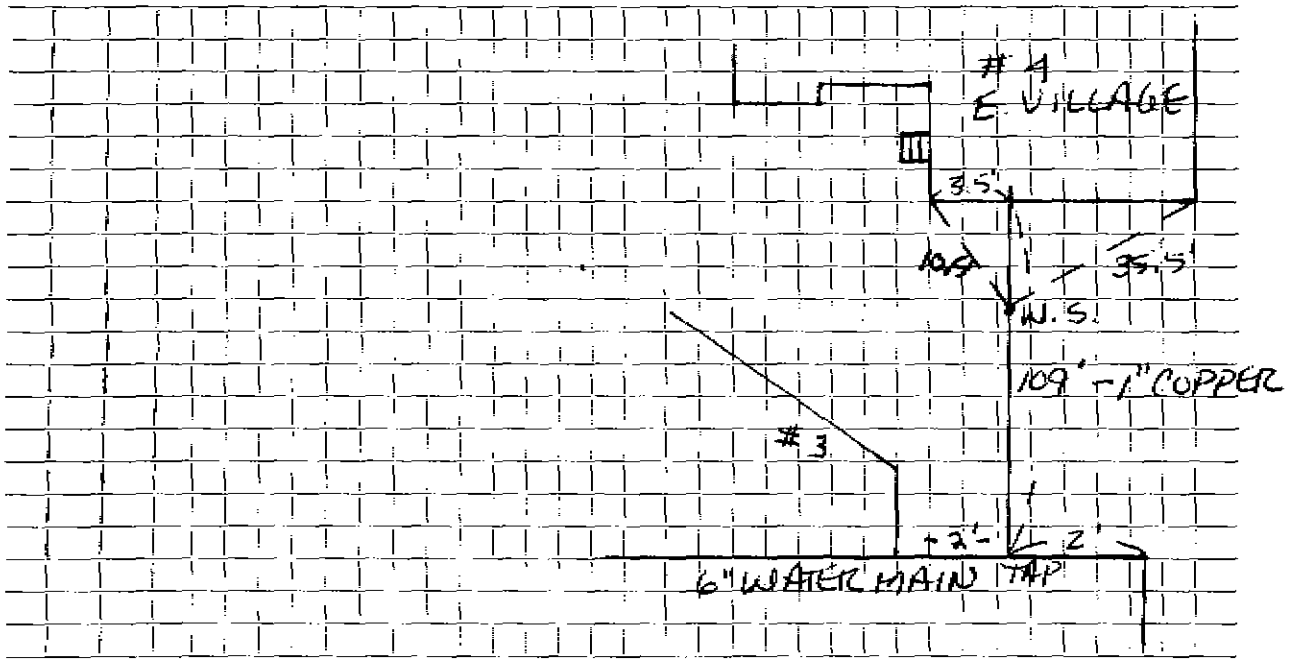

Connection made in ... SPENCER ... Street. Work completed ... 4-7-76 ...

Remarks:

.....

.....