

WATER SERVICE RECORD

#4975

Name Manuel Souza

Service No. 219

Address 12 Eastern Av.

Location

Repair ~~Work~~ - New Service

*Com. 9-14-53*

Date	Material	Amount	Total	Date	Amount
8/11/53	Labor	20 33		7-31-53 Deposited	125 00
	10% overhead	2 03	22 36	9-14-53 Refunded	18 61
	80' - 1" copper tubing@.48		38 40		<u>106 39</u>
	1 - 1"C x 3/4" I.W.H. stop & waste	5 12		8/11/53 Labor	30 00
	1 - 1"C x 1"C. union 3 pts.	2 26		140' - 1" copper tubing@.48	67 20
	5 hrs. Littlefield shovel@ 7.50	37 50		1 - 1" C. corp-cock	5 61
	1 hr. trucking		75	1 - 1"C x 1"C. curb-cock	6 80
			106 39	2 - 1"C x 1"C. unions 3pts. @2.26	4 52
				1 box and rod	3 90
				1 - 3/4" Straight tail pc.	50
				1 - 3/4" offset tail pc.	50
				4 hrs. Littlefield shovel@7.50	30 00
				1 hr. trucking	75
					<u>149 78</u>


DATE \_\_\_\_\_

TOWN OF LEXINGTON — BOARD OF PUBLIC WORKS

WATER DIVISION

Sketch of Service Here

SERVICE #12 EASTERN AVE.

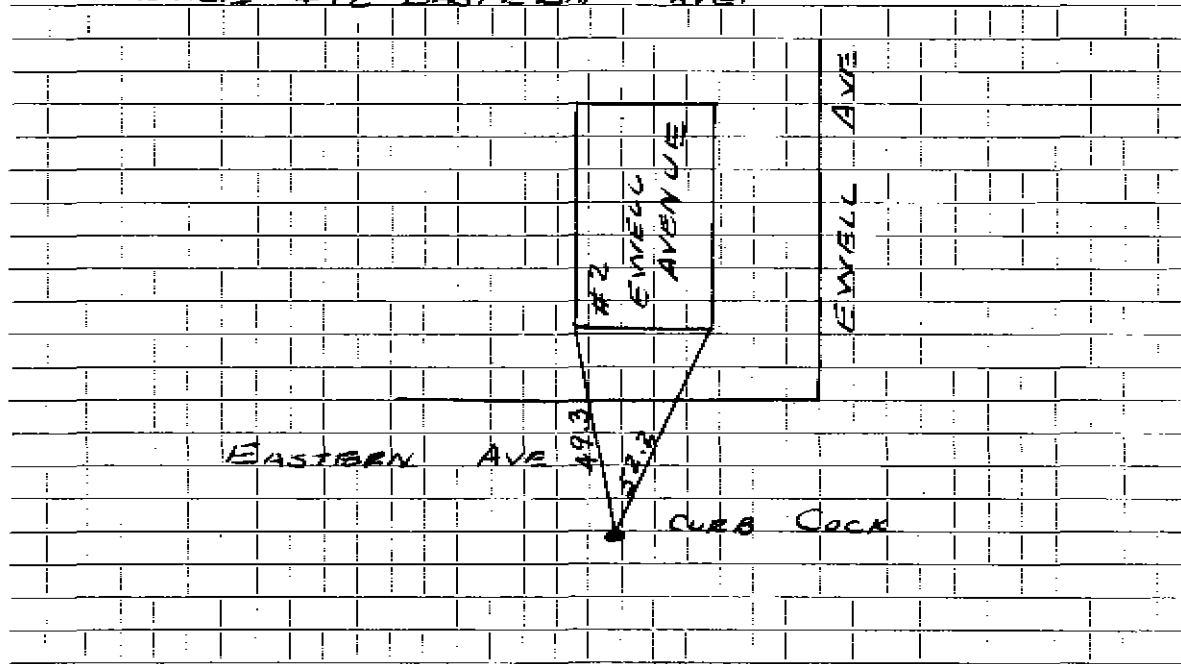

Connection made in ..... Street. Work completed .....

Remarks: .....

.....

.....