

WATER SERVICE RECORD

Name Herbert McConchie

Service No. 272

Address 20 Eastern Avenue

#2561

Location

~~Repair/Removal~~ - New Service

Com 12-17-60


Date	Material	Amount	Total	Date	Amount
11-21-60	Labor	1 69		11-15-60	25 00
	10% O.E.	17	1 86	12-12-60	2 35
46'	3/4" Copper tubing @.42		19 32		37 35
1	3/4" Cx 1/2 I.W.F. Stop & Waste	6 17			NON CHARGE
			27 35	5-10-60	3.82
					37' 3/4" Copper tubing @.42
					1 3/4" C Corp Cock
					1 3/4" C Curb Cock
					1 Box & Rod
					35.55
					1 1/2 Straight tailpiece
					1 1/2 Offset tailpiece
					50
					50
					36 55

DATE \_\_\_\_\_

TOWN OF LEXINGTON — BOARD OF PUBLIC WORKS

**WATER DIVISION**

Sketch of Service Here

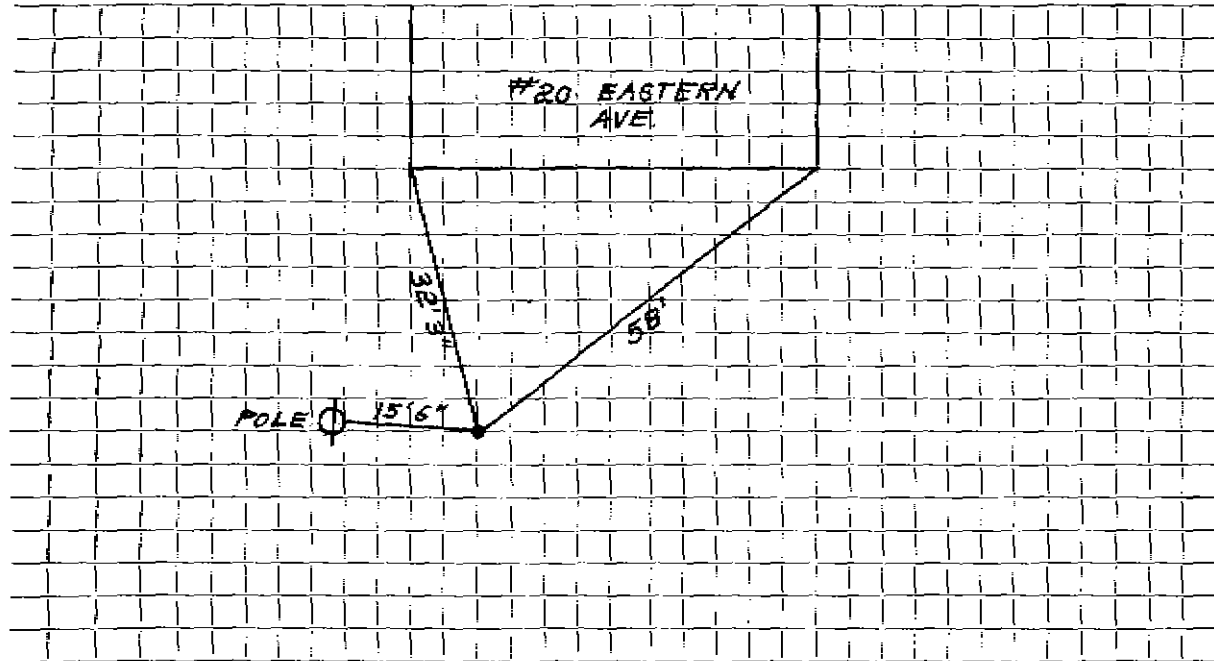

Connection made in ..... Street. Work completed .....

Remarks: .....

.....  
.....