

WATER SERVICE RECORD

5892

Name Charles H. Murray

Service No. 296

Address 24 Eastern Ave.

Location

~~Repair - Renewal~~ - New Service

Cmn 12-31-60

Date	Material	Amount	Total	Date	Amount	
12-7-60	Labor	3.88		12-15-60	Deposit	2.50
	10% O.H.	.39	4.27	12-31-60	Paid by Street 225	10.20
53'	3/4" Copper tubing @.42		22.26			7.50
1	3/4" C x 1/2 I.W.H. Stop & Waste		6.17		NON CHARGE	
1	hr. Trucking @3.00		3.00	5-10-60	Labor	3.82
			35.70	25'	3/4" Copper tubing @.42	10.50
				1	3/4" C Corp Cock	4.91
				1	3/4" Curb Cock	6.28
				1	Box & Rod	5.00
						30.51
				1	1/2 Straight tailpiece	.50
				1	1/2 Offset tailpiece	.50
						31.51


DATE _____

TOWN OF LEXINGTON — BOARD OF PUBLIC WORKS

WATER DIVISION

Sketch of Service Here

W.S. For #24

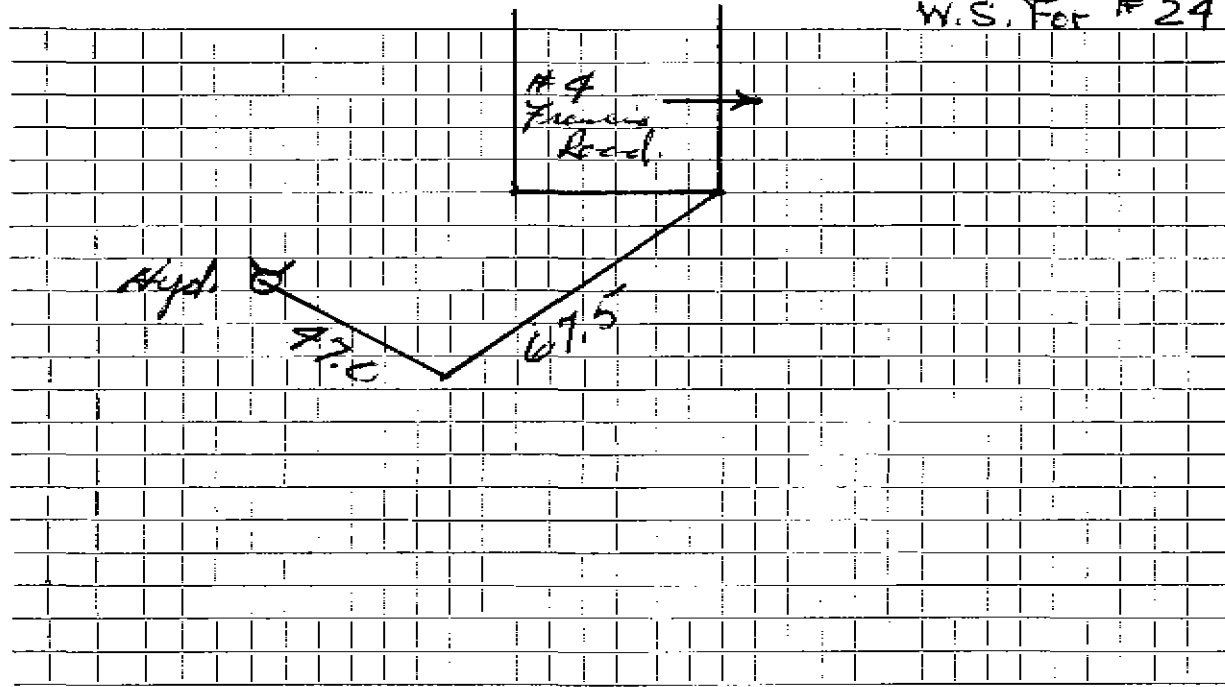

Connection made in Street. Work completed

Remarks:
.....
.....