

## WATER SERVICE RECORD

# 3848

Water Misc.

Name Charles H. Murray

Service No. 41

Address 25 Eastern Ave.

Location

Repair—~~Renewal~~ New Service

Comm. 7-25-60


Date	Material	Amount	Total	Date	Amount
6-18-60	Labor	10 17		5/10/60	
	10 % O.H.	1 02	11 19	16' 3/4" Copper	
20'	3/4" Copper Tubing @ .12		8 40	1 3/4" C. Corp Cock	
1	3/4" C 3 Part Unions @ 2.41		2 41	1 3/4" C. Curb Cock	
1	Box & Rod @ 5.00		5 00		
1	Hr. Pippin Shovel @ 6.50		6 50		
1	Hr. Trucking @ 3.00		3 00		
			<u>36 50</u>		

DATE \_\_\_\_\_

TOWN OF LEXINGTON — BOARD OF PUBLIC WORKS

WATER DIVISION

Sketch of Service Here

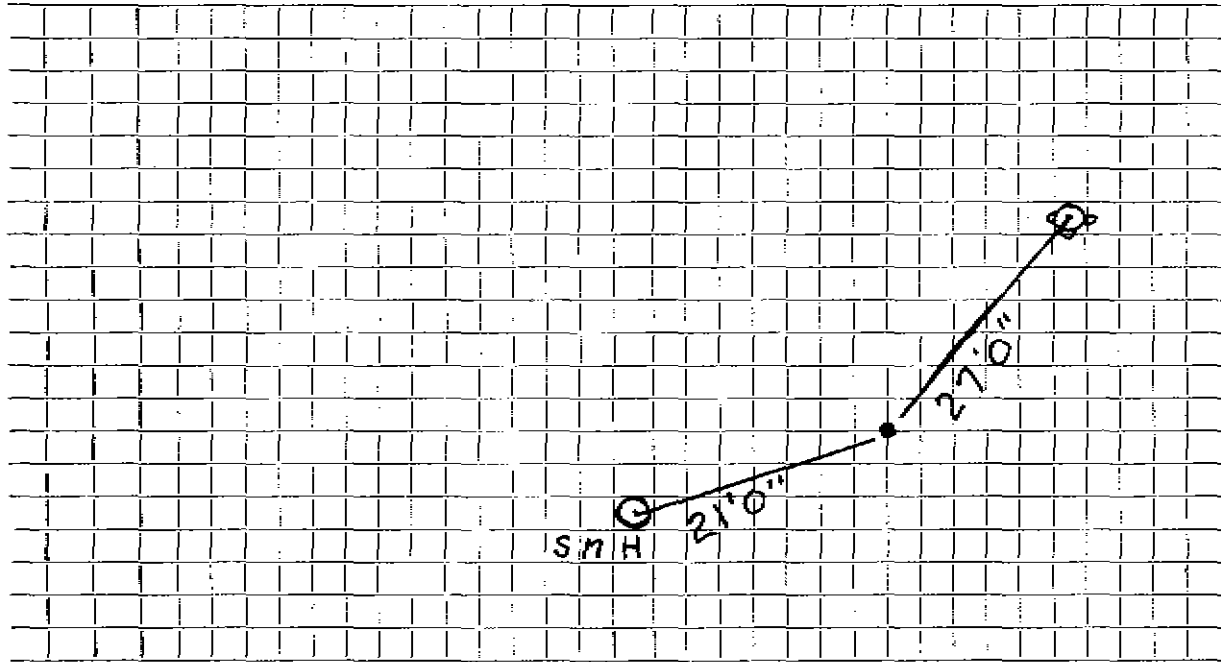

Connection made in ..... Street. Work completed .....

Remarks: .....

.....

.....