

WATER SERVICE RECORD

Name John Reichel & son John Gullacher

Service No. 116

Address 26 Eastern Ave.

4665, 7190

Location

~~Repair Work~~ - New Service

Comm 9-22-60

Date	Material	Amount	Total	Date	Material	Amount
7-2-60	Labor	1 94		7-7-60	Deposit	50 00
	10% O.K.	19	2 13	5-22-60	Retained	16 19
55'	3/4" Copper tubing @.42		23 10			33 51
1	3/4" I.P.F. Stop Waste		6 17		NON CHARGE	
1	3/4" CS part Union		2 41	5-11-60	Labor	1 94
			33 81		50' 3/4" Copper tubing @.42	21 00
					1 3/4" C Corp Cock	4 91
					1 3/4" C Curb Cock	6 28
					1 Box & Rod	5 00
						39 18
					1 5/8" Straight tailpiece	50
					1 1/2" Offset tailpiece	50
						40 13


DATE _____

TOWN OF LEXINGTON — BOARD OF PUBLIC WORKS

WATER DIVISION

Sketch of Service Here

W.S. For # 26

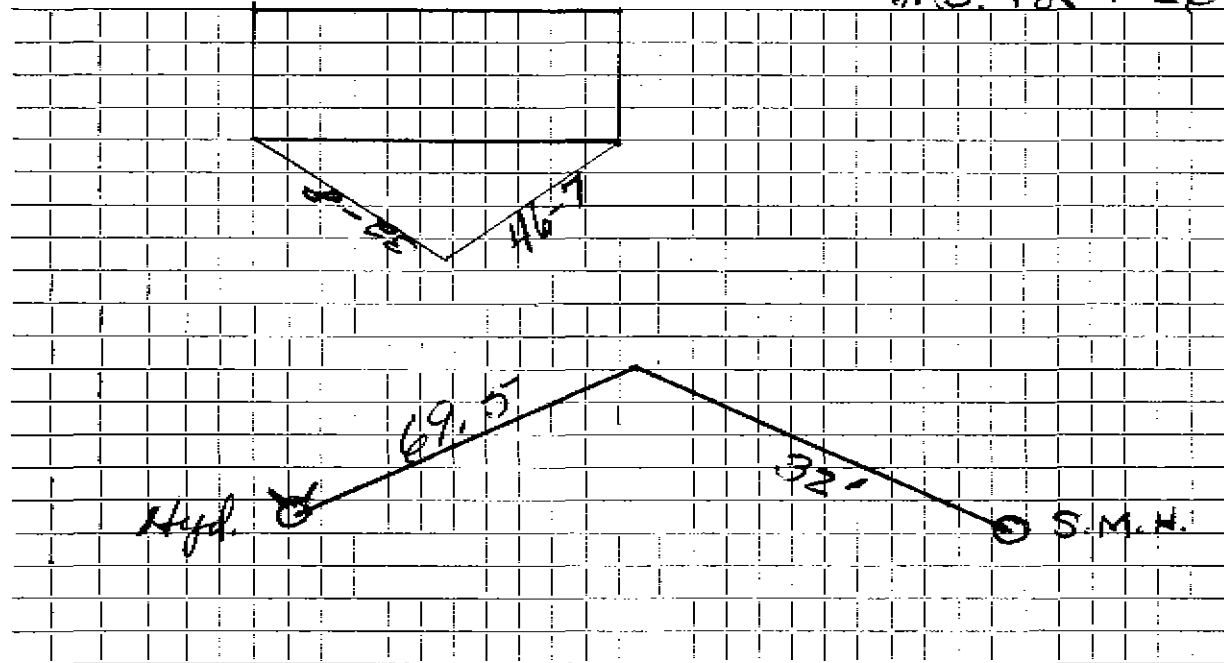

Connection made in Street. Work completed

Remarks:

.....

.....