

## WATER SERVICE RECORD

Name Herbert McConchie

Service No. 109

Address 29 Eastern Avenue

Location

~~Repair - Repair~~ New Service

Comm 9-25-61


Date	Material	Amount	Total	Date	Amount	
8-19-61	Labor	4.26		8-2-61	Deposit	35.00
	105 C.F.	.43	4.69	9-25-61	Paid by SHC#98	78
11	3/4" Copper tubing @.42	4.22	17.22			35.98
1	3/4" G x 1/2" I.P.S. top & Waste		6.17		NON CHARGE	
1	Box & Rod		4.90	7-7-60	Labor	3.47
1	hr. Trucking @3.00		3.00	18	3/4" Copper tubing @.42	7.56
			35.98	1	3/4" G Corp Cock	4.91
				1	3/4" G Curb Cock	6.28
				1	Box & Rod	5.00
						27.22
				1	1/2" Straight tailpiece	.50
				1	1/2" Offset tailpiece	.50
						28.22

DATE \_\_\_\_\_

**TOWN OF LEXINGTON — BOARD OF PUBLIC WORKS**

**WATER DIVISION**

Sketch of Service Here

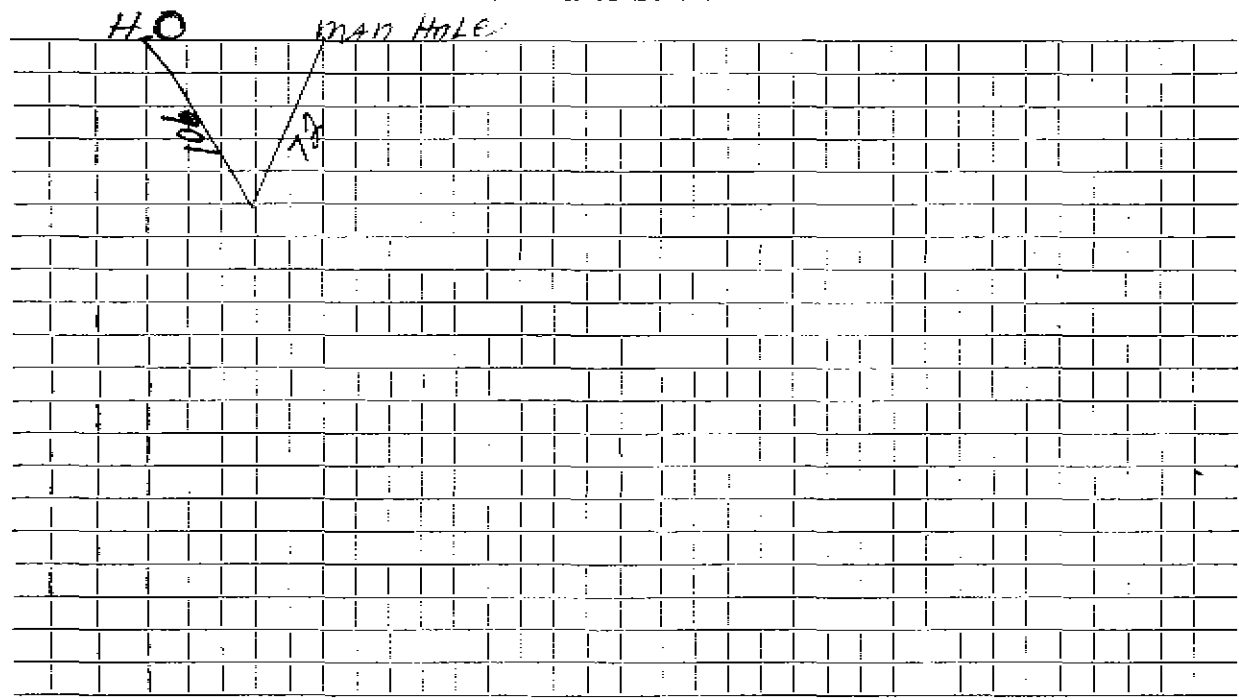

Connection made in ..... Street. Work completed .....

Remarks: .....  
.....  
.....