

## WATER SERVICE RECORD

Name Herbert McConchieService No. 110Address 30 Eastern Avenue


Location \_\_\_\_\_

~~Repair~~ ~~Renew~~ New ServiceComm 9-25-61

Date	Material	Amount	Total	Date	Amount	
8-3-61	Labor	2.32		8-2-61	Deposit	35.00
	10% O.H.	.23	2.55	9-25-61	Refund	5.28
50	3/4" Copper tubing @.42	21.00				29.72
1	3/4" 8 x 1/2 I.H.H. Stop & Waste	6.17				
			29.72		NOT CHARGE	
				7-7-60	Labor	3.47
				20'	3/4" Copper tubing	10.92
				2	3/4" 8 Curv Cook	6.29
				1	3/4" 8 Corp Cook	4.61
				1	Box 8: 800	4.90
					<del>TRH <del>documented</del></del>	30.48
				1	1/2" Straight tailpiece	.50
				1	1/2" Offset tailpiece	.50
						31.48

TOWN OF LEXINGTON — BOARD OF PUBLIC WORKS  
**WATER DIVISION**

Sketch of Service Here

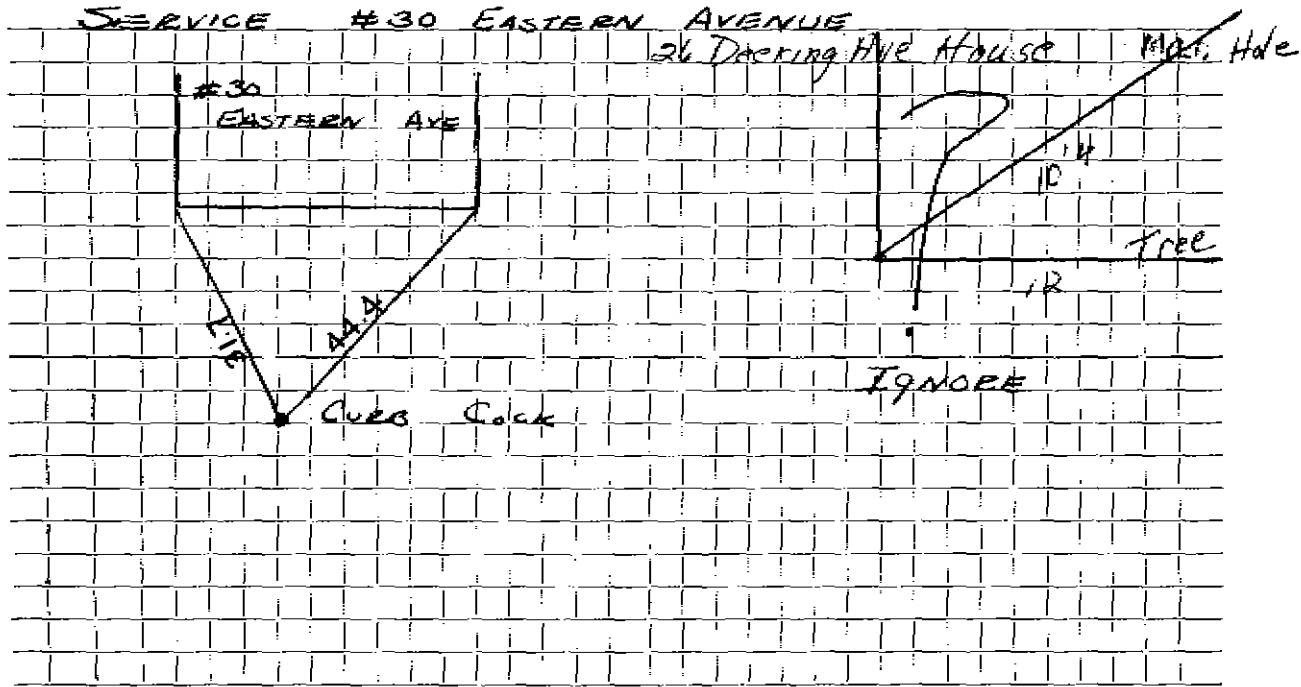

Connection made in ..... Street. Work completed .....

Remarks: .....

.....  
.....