

WATER SERVICE RECORD

4833

Name Herbert McConchie

Service No. 55

Address 32 Eastern Avenue

Location


~~Repair - Renewal~~ - New Service

Comm 6-19-61

Date	Material	Amount	Total	Date		Amount
5-19-61	Labor	4.36		5-10-61	Deposit	40.00
	10% O.H.	.44	4.80	6-19-61	Retard	2.29
52'	3/4" Copper Tubing @.42		21.84			37.71
1	3/4" c x 1/2 I.W.H. Stop & Waste		6.17		NON CHARGE	
1	Box & Rod		4.90	7-6-60	Labor	3.47
			37.71			
				30'	3/4" Copper tubing @.42	12.60
				1	3/4" C Corp Cock	4.91
				1	3/4" C Curb Cock	6.28
				1	Box & Rod	5.00
						32.26
				1	1/2 Straight tailpiece	.50
				1	1/2 Offset tailpiece	.50
						33.26

TOWN OF LEXINGTON — BOARD OF PUBLIC WORKS
WATER DIVISION

Sketch of Service Here

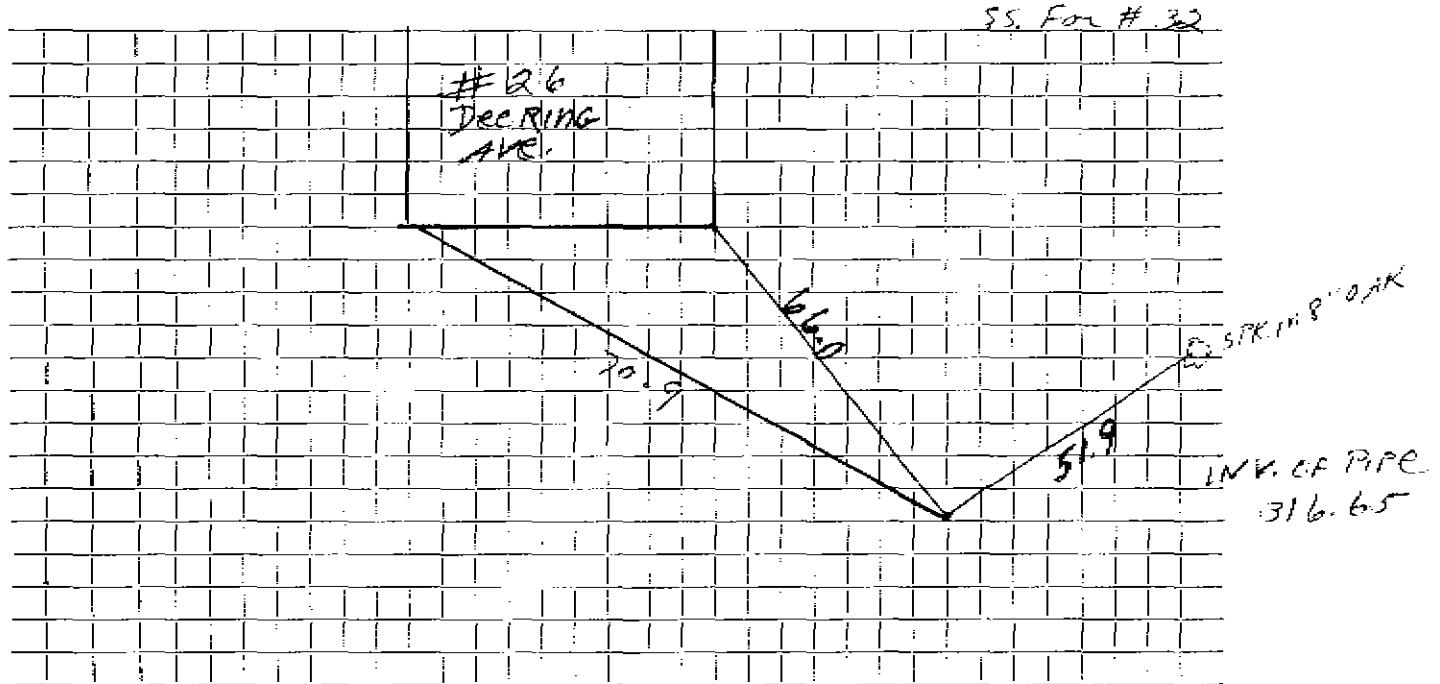

Connection made in Street. Work completed

Remarks:
.....
.....