

WATER SERVICE RECORD

Name Herbert McConchie

Service No. 61

Address 142 Eastern Ave.

Location

~~Repair~~ ~~Renewal~~ - New Service


Conn 25 ft

Date	Material	Amount	Total	Date	Amount
5-7-60	Labor 3.99			5-6-60	50 00
	10% O.H. .40		4 39	7-5-60	18 44
	50' 3/4" Copper tubing @ .42		21 00		31 56
	1 3/4" Cx 1/2 I.W.H. Stop & Waste		6 17		
			31 56		
				1	1/2 Offset tailpiece 50
6/23/60	2' 3/4" Copper			1	1/2 Straight tailpiece 50
	2 3/4" C. - 3 Part Union				1 00

TOWN OF LEXINGTON — BOARD OF PUBLIC WORKS

WATER DIVISION

Sketch of Service Here

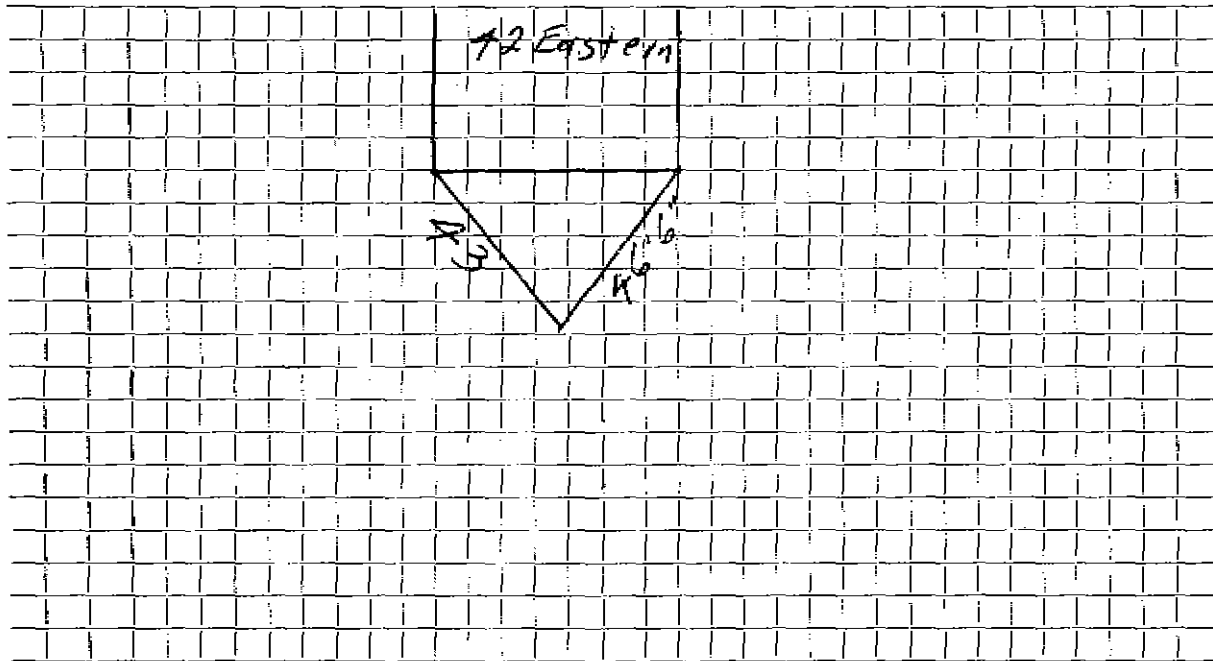

Connection made in Street. Work completed

Remarks:

.....

.....