

## WATER SERVICE RECORD

Name John Reichheld

Service No. 103

Address 114 Eastern Avenue

Location

~~Repair~~ ~~Renewal~~ - New Service


Comm 8-1-48

Date	Material	Amount	Total	Date	Amount
6-29-60	Labor	1.94		6-29-60	30 00
	10% O.H.	.19	2.13	7-1-48	4 80
140'	3/4" copper tubing @.42		16.80		25 40
1	3/4" Cx 1/2 IWH Stop & Waste		6.17		
			25.10		
				7-31-59	
					<u>NON CHARGE</u>
					Labor
				22'	3/4" Copper tubing @.38
				1	3/4" C Corp Cock
				1	3/4" C Curb Cock
				1	Box & Rod
					<u>5 00</u>
					27 80
				6-29-60	1 1/2 Straight tailpiece
					50
					1 1/2 Offset tailpiece
					<u>50</u>
					28 80

DATE \_\_\_\_\_

**TOWN OF LEXINGTON — BOARD OF PUBLIC WORKS**  
**WATER DIVISION**

Sketch of Service Here

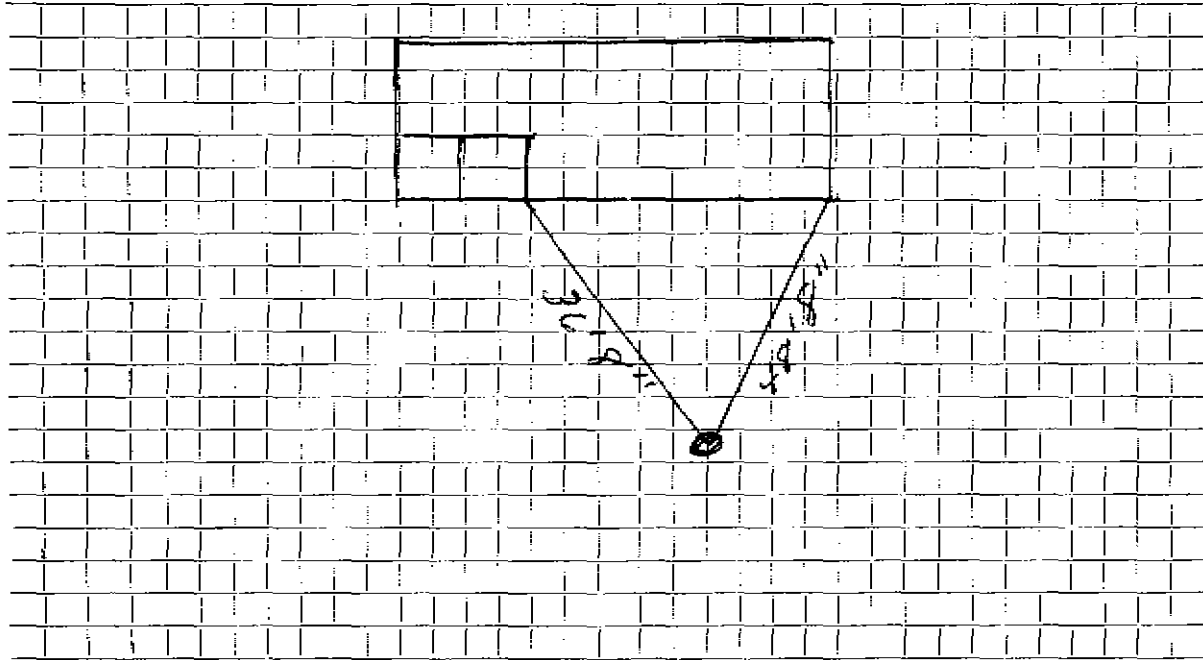

Connection made in ..... Street.      Work completed .....

Remarks: .....  
.....  
.....