

WATER SERVICE RECORD

5565

Name Herbert McConchie

Service No. 62

Address 46 Eastern Avenue

7043

Location

~~Repair~~ ~~Renewal~~ - New Service


Comm 5-16-60

Date	Material	Amount	Total	Date		Amount
5-9-60	Labor	1.94		5-9-60	Deposit	50.00
	10% O.H.	.20	2.14	5-16-60	Retard	6.94
77'	3/4" Copper tubing @.42		32.34			43.06
1	3/4" C x 1/2" I.W.F. Stop & Waste	6.17			NON CHARGE	
1	3/4" C 3 part union	2.41			Labor	1.88
			43.06	33'	3/4" Copper tubing @.42	13.86
				1	3/4" C Corp Cock	4.91
				1	3/4" C Curb Cock	6.28
				1	Box 1 Rod	5.00
				1	1/2" Straight Tailpiece	.50
				1	1/2" Offset tailpiece	.50
						32.93

DATE _____

TOWN OF LEXINGTON — BOARD OF PUBLIC WORKS
WATER DIVISION

Sketch of Service Here

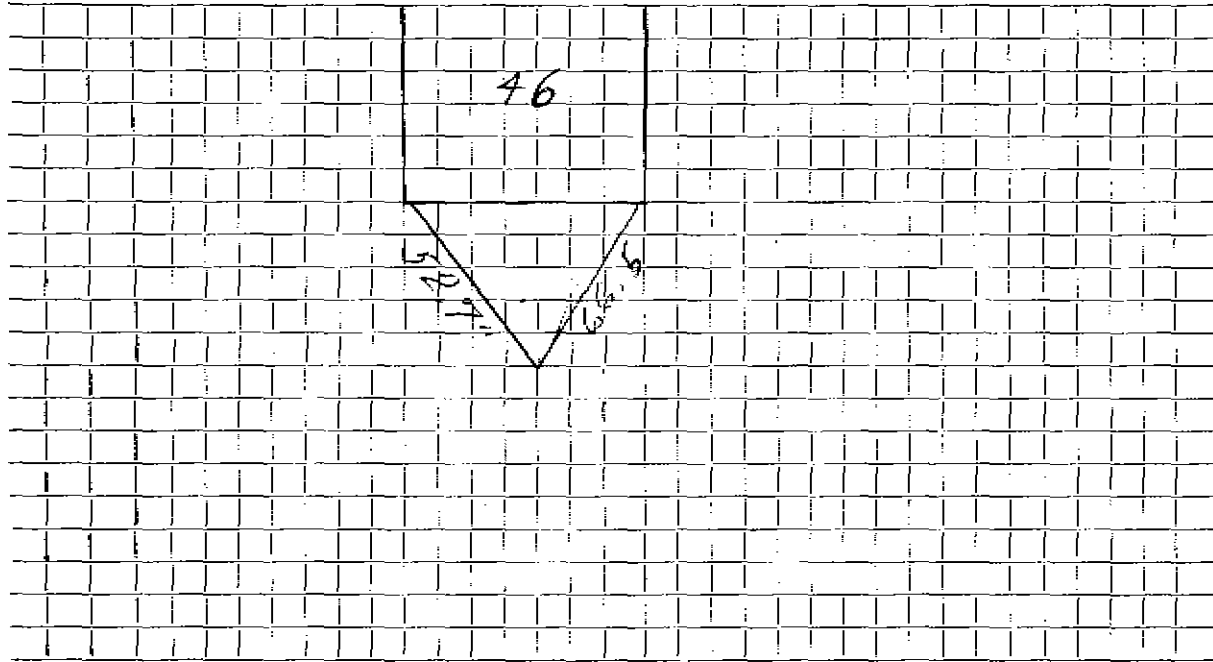

Connection made in Street. Work completed

Remarks:

.....
.....