

WATER SERVICE RECORD

#5767

Name H. M. Besecker

Service No. 218

Address 8 Eastern Ave.,

Location Lexington

Repair ~~X~~ Renewal — New Service

*Com 9-14-53*


Date	Material	Amount	Total	Date	Amount
7/11/53	Labor	1 75		7-31-53	50 00
	10% Overhead	18	1 93	9-14-53	635 82
	1 3/4" C x 1/2 I.W.H. stop & waste	4 00	4 00		NON CHARGE
	1 hr. Littlefield shovel		7 50	7/11/53	Labor 8 25
	1 hr. trucking		75		80' 3/4" Copper tubing @ .3629 29 03
			14 18		1 3/4" C. cbrp-cock 4 33
	PIPE SUPPLIED & LAID BY OWNER				1 3/4" C x 3/4" C. curb cock 4 67
					1 3/4" C x 3/4" C. Union 3 pts. 1 72
					1 box and rod 3 90
					1 - 1/2 offset tail piece 50
					1 - 1/2 straight tail piece 50
					2 hrs. Littlefield shovel 15 00
					1 hr. trucking 75
					68 65

DATE \_\_\_\_\_

TOWN OF LEXINGTON — BOARD OF PUBLIC WORKS

WATER DIVISION

Sketch of Service Here

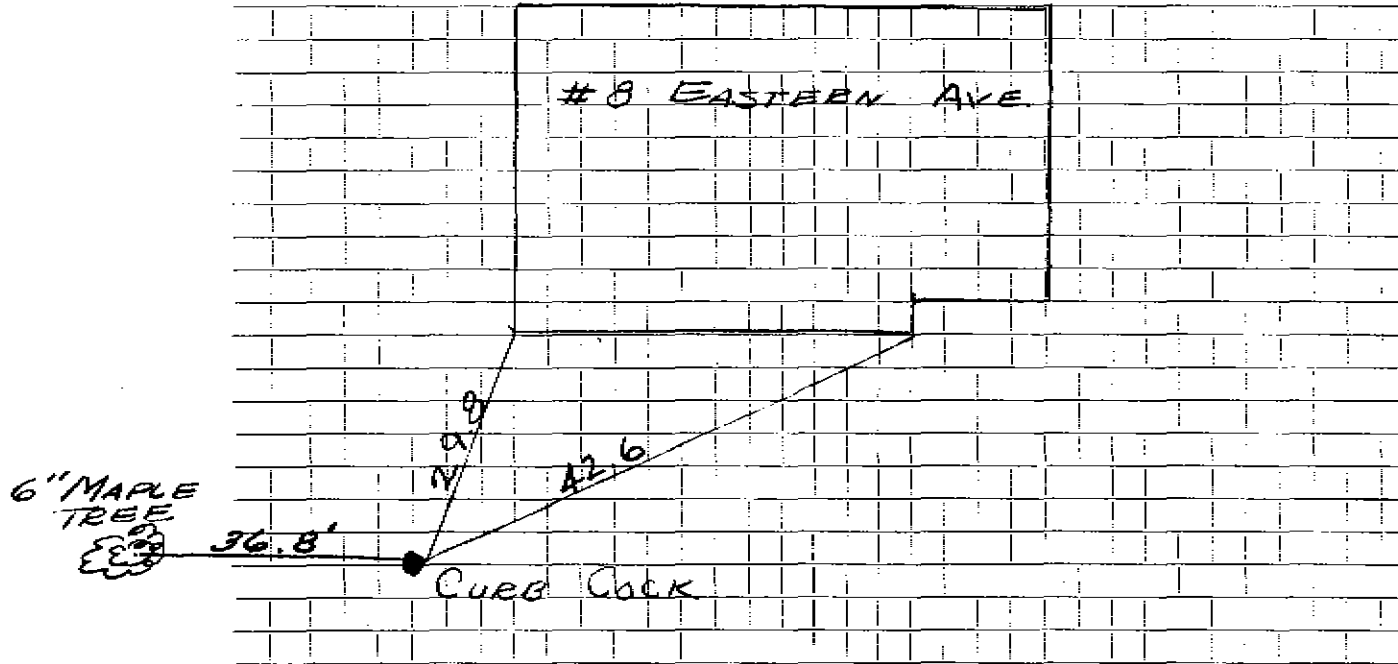

Connection made in ..... Street. Work completed .....

Remarks: .....

.....  
.....