

Name Stanley E. Cliff

2150
Service No. ~~54~~ 781

Address Simonds Road
10 Eaton

Location Lots 20, 21 Eaton Road

Kind of Pipe Size Size of Main

~~Repair-Renewal~~—New Service Location

Date	Material	Amount	Total	Date	Amount
11/4/33	33' 1" C.L. Pipe @.17	\$5 61			
Com. 14	2 1" L.L. Coups. @.20	40			
11-21-33	1 S & W	<u>2 75</u>	\$9 51		
	4 Hrs. Labor @.55	2 20			
	3 " " @.60	<u>1 80</u>	4 00		
	10% Overhead		40		
	COST		<u>\$13 91</u>		
	33' @.45 is \$14.85, but Cliff deposited \$14.00, so say,		<u>\$14 00</u>		
	Labor				

Oct. 20 1933 - Cash 14 -
checked 7-25-94
Outside
3/4 Copper

McClary Press, Inc., Lexington

DATE October 20, 1933

TOWN OF LEXINGTON—BOARD OF PUBLIC WORKS

WATER DIVISION

The undersigned applies for a supply of water at No. ^{Lots #13} 20 & 21 Eaton Rd St. and hereby agrees to comply with the rules and regulations as now, or at any future time, established by the Board of Selectmen.

Am't. of Estimate \$ 1.00

Owner F. G. Forbes


Am't. Paid \$ 1.00

Address Eaton Rd

Builder H. E. Cliff

Lexington

Sketch of Service Here

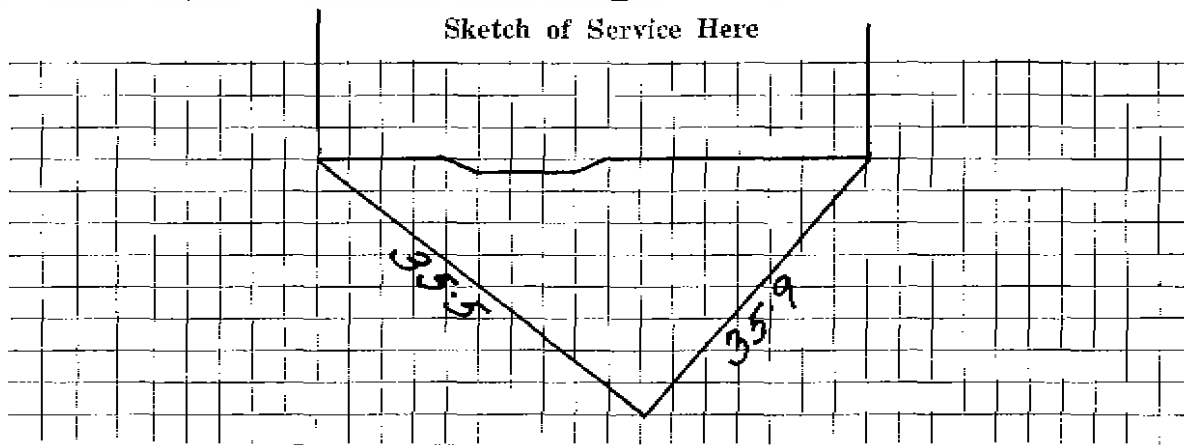

Connection made in _____ Street. Work completed _____ 19

Remarks: