

Name Innis C. McLennan

Service No. ~~78~~ 782

Address Billerica, Massachusetts

11 Eaton

Location

11 Eaton Road

1788

Kind of Pipe

Size

Size of Main

Repair—Renewal—New Service

Location

Date	Material	Amount	Total	Date	Amount
May 3, 1940	4 hrs. @ 60¢	2 40		May 1, 1940	25 00
SM 6/11/40	10% Overhead	<u>24</u>	2 64	June 1, 1940	<u>6 38</u>
	35' 3/4" Copper tubing	18 00	6 30		18 62
	1 3/4" Cx 1/2" I S. & W.		2 25		
	1 hr. trucking @ 75¢		75		
	Trench repairs		<u>6 68</u>		
			18 62		
	Labor				

DATE May 1 1917

TOWN OF LEXINGTON—BOARD OF PUBLIC WORKS
WATER DIVISION

The undersigned applies for a supply of water at No. 11 Eaton Pt St. and hereby agrees to comply with the rules and regulations as now, or at any future time, established by the Board of Selectmen.

Am't. of Estimate \$ 75


Owner James & W. Lennan

Am't. Paid \$ _____

Address Boston Pt Ballerica
In L.P. Union

Builder Robert L. Lewis

Sketch of Service Here

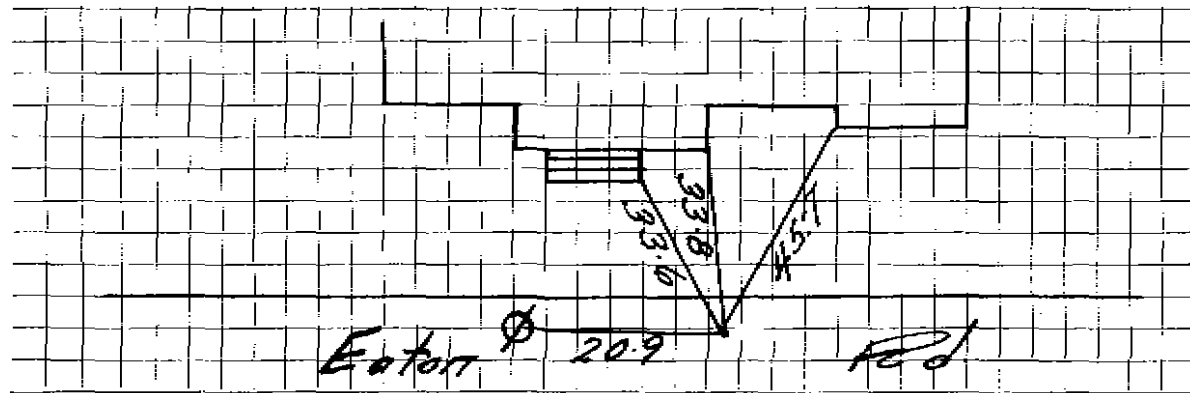

Connection made in _____ Street. Work completed _____ 19

Remarks: