

Name

Service No. 783

Address 12 Eaton

Location 12 Eaton Rd.

Kind of Pipe

Size

Size of Main

Repair—Renewal—New Service

Location

Date

Material

Amount

Total

Date

Amount

Labor

DATE _____

TOWN OF LEXINGTON - BOARD OF PUBLIC WORKS

WATER DIVISION

The undersigned applies for a supply of water at No. _____ St. and hereby agrees to comply with the rules and regulations as now, or at any future time, established by the Board of Selectmen.

Am't. of Estimate \$ _____


Owner Mann

Am't. Paid \$ _____

Address 12 Eaton Rd.

Builder _____

Sketch of Service Here

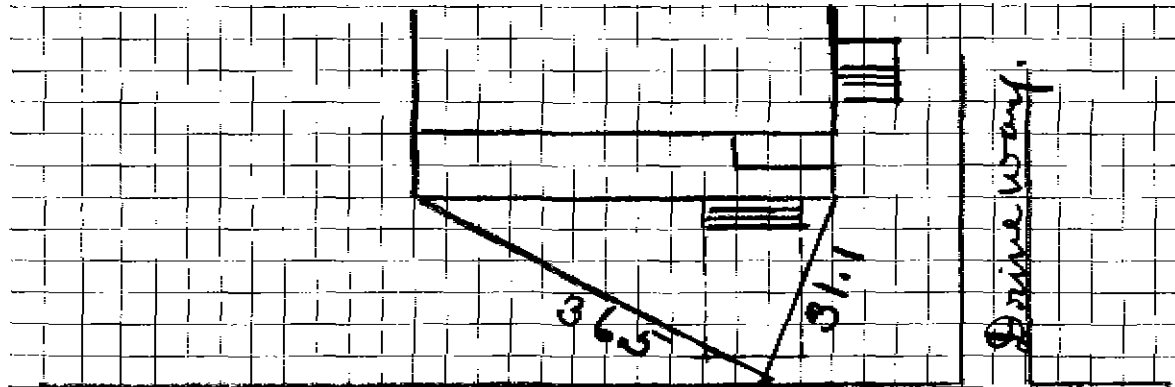

Connection made in Eaton Street. 12 Eaton Rd Work completed _____ 19__

Remarks: