

WATER SERVICE RECORD

Name Ernest F. Outhet

Service No. 155

Address 16 Eaton Rd., Lexington

2993

Location

~~Repair~~—~~Renewal~~—New Service


Comm. 11-19-56

| Date | Material | Amount | Total | Date | Amount | |
|--------|----------------------------------|--------|-------|------------------------------|-------------------|-------|
| 7/9/56 | Labor | 11 05 | | 6-11-56 | Deposit | 50 00 |
| | 10% Overhead | 1 11 | 12 16 | 11-19-56 | Refund | 12 73 |
| | 40' 3/4" Copper tubing @.4850 | | 19 40 | | <u>NON CHARGE</u> | 37 27 |
| | 1-3/4" C x 1/2" IWH stop & waste | | 4 96 | 7/9/56 | Labor | 5 85 |
| | 1 hr. Trucking @.75 | | 75 | 22-3/4" Copper tubing @.4850 | | 10 67 |
| | | | 37 27 | 1-3/4" Corp Cock | | 4 64 |
| | | | | 1-3/4" C Gurb Cock | | 5 94 |
| | | | | 1 Box & Rod | | 4 62 |
| | | | | 1-1/2" Syraight Tail Piece | | 50 |
| | | | | 1-1/2" Offset Tail Piece | | 50 |
| | | | | | | 32 72 |

DATE _____

TOWN OF LEXINGTON — BOARD OF PUBLIC WORKS
WATER DIVISION

Sketch of Service Here

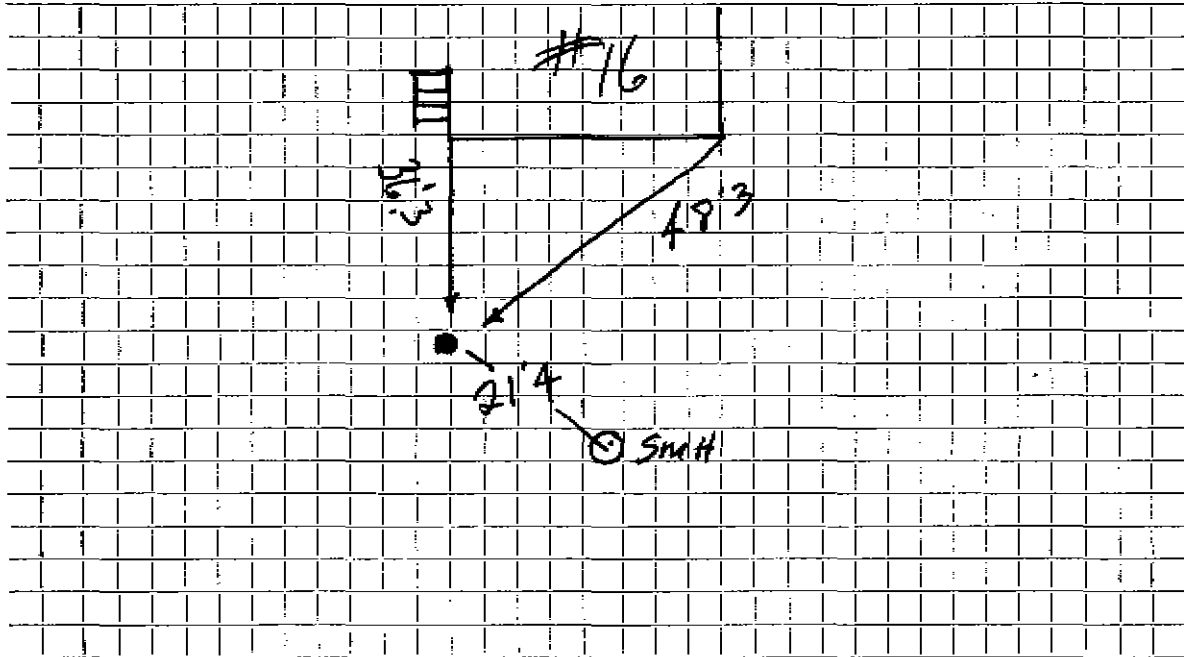

Connection made in Street. Work completed

Remarks:

.....

.....