

Name H. C. Currier

Service No. ~~48~~ 784
#6241

Address 18 Wright St., Arlington
19 Eaton

Location 19 Eaton Road

Kind of Pipe

Size

Size of Main

Repair—Renewal—New Service

Location

Date
1940

Material

Amount

Total

Date

Amount

Sept. 9, 1940	2 hrs @ 80¢	1 20			
Com 9/30/40	10% Overhead	<u>12</u>	1 32		
	37' 3/4" Copper tubing @ 18¢		6 66		
	1 3/4" C.x 1/2" I.S. & W.		2 25		
	1 hr. tracking @ 75¢		75		
	Trench repairs		<u>2 78</u>		
			13 76		

August 28, 1940 Deposited
October 2, 1940 Refunded

20 00
<u>6 24</u>
13 76

Labor

DATE 7-20-40

TOWN OF LEXINGTON—BOARD OF PUBLIC WORKS
WATER DIVISION

The undersigned applies for a supply of water at No. 19 Eaton Rd St. and hereby agrees to comply with the rules and regulations as now, or at any future time, established by the Board of Selectmen.

Am't. of Estimate \$ _____

Owner

H. S. Currier

Am't. Paid \$ _____


Address

19 Eaton Rd

Builder J. J. Currier

Lexington

Sketch of Service Here

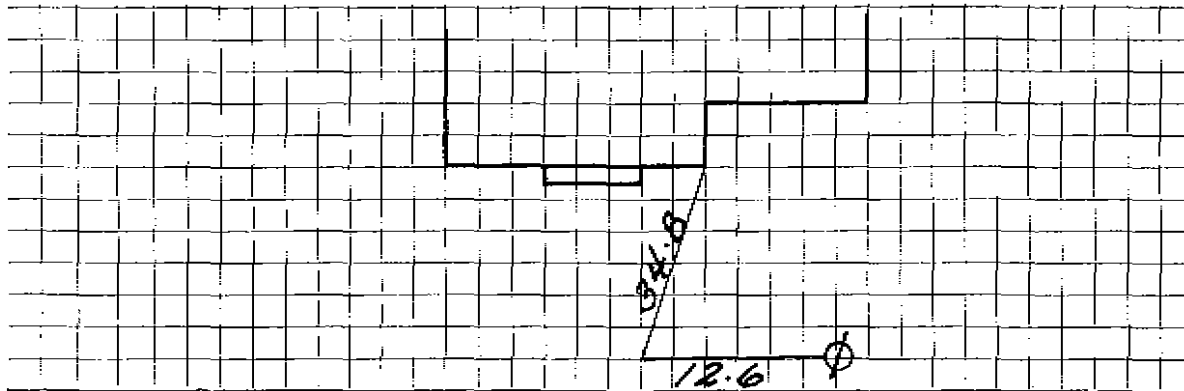

Connection made in _____ Street.

Work completed _____ 19

Remarks: