

WATER SERVICE RECORD

Name

Service No.

Address

Location

23 Eaton Rd

Repair—Renewal—New Service


Date	Material	Amount	Total	Date	Amount	
MAY 19, 1999	Inside renewed 73' of 1" Copper 1- 1" Comp. 3 pt union 1- 1" x 3/4" comp 3pt union			7.20.94	Outside 10.7 - 3/4" Copper 1- 3/4 Comp corp 1- 3/4 Comp cuels 1- Box + Rod	

DATE _____

TOWN OF LEXINGTON — BOARD OF PUBLIC WORKS

WATER DIVISION

Sketch of Service Here

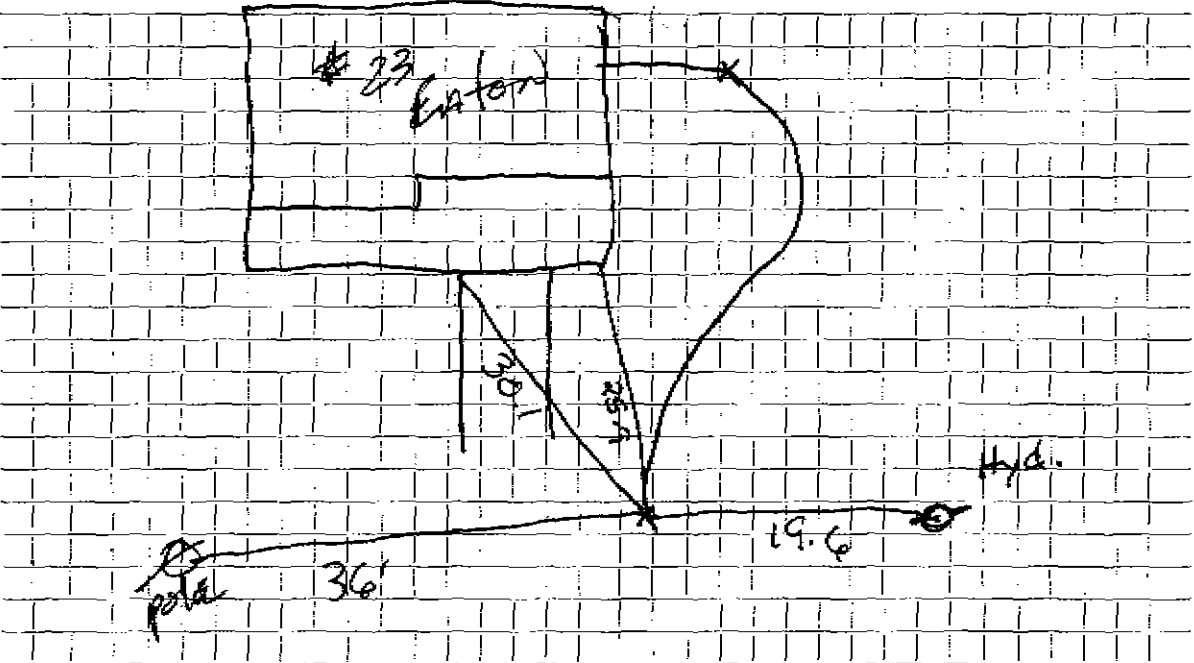

Connection made in Street. Work completed

Remarks:
.....
.....