


DATE _____

TOWN OF LEXINGTON — BOARD OF PUBLIC WORKS

WATER DIVISION

Sketch of Service Here

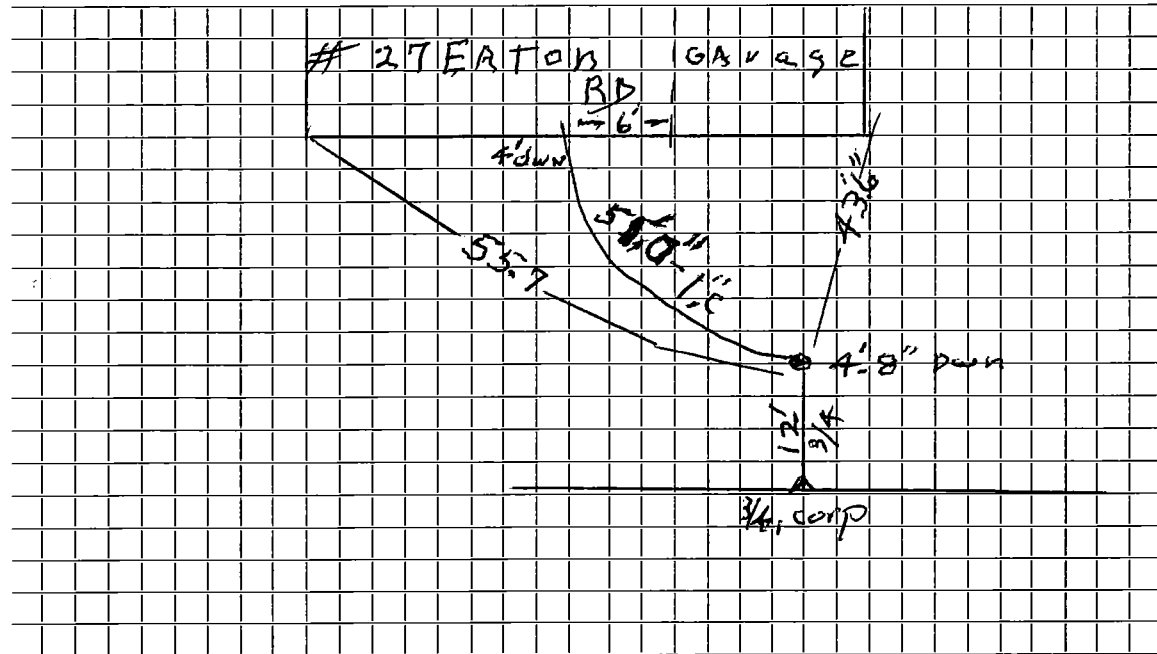

Connection made in Street.

Work completed 9/19/52 J. McLaughlin

Remarks: WATER SERVICE CROSSES SEWER SERVICE 1N x 5' from curb.....

.....
.....