

Name Manuel DeMello

Service No. ¹¹⁻¹ 3389

Address ²⁸ ~~30~~ Eaton Road

5318

Location ²⁸ ~~30~~ Eaton Road

Kind of Pipe

Size

Size of Main

~~Repair-Overhaul~~ New Service

Location

Date	Material	Amount	Total	Date	Amount
Oct. 25, '47	Labor	1 10	1 10	Oct 14 '47	15 00
	10% Overhead		11		
	36' - 3/4" Copper Tubing @ .26		9 36		
	1 - 3/4" C x 1/2" I.W.H. S & W		3 15		
	Trucking 1 hr. @ .75		75		
			14 47		
				Oct. 25, '46	21 10
				24' - 3/4" Copper Tubing @ .26	6 24
				1 - 3/4" C Corp-cock	3 00
				1 - 3/4" C x 3/4" C Curb-cock	3 68
				1 - Box & Rod	4 26
				Hired Shovel 2 hrs. @ 7.00	14 00
				1 - 1/2" Offset Tail Piece	30
				1 - 1/2" Straight Tail Piece	30
				Trucking 1 hr. @ .75	75
	Labor				53 63

Separated

Non-Charge

DATE _____

TOWN OF LEXINGTON - BOARD OF PUBLIC WORKS

WATER DIVISION

The undersigned applies for a supply of water at No..... St. and hereby agrees to comply with the rules and regulations as now, or at any future time, established by the Board of Selectmen.

Am't of Estimate \$.....


Owner

Am't Paid \$.....

Address

Builder

Sketch of Service Here

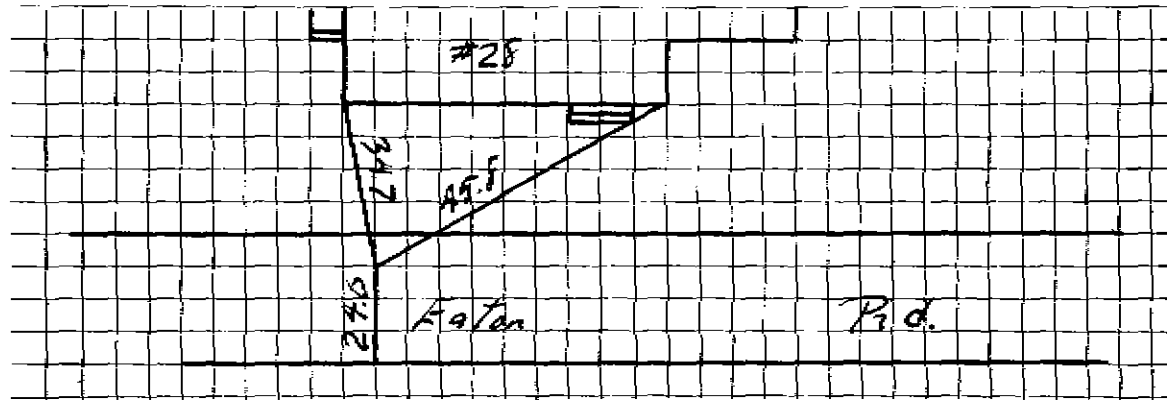

Connection made in Street.

Work completed19

Remarks: