

Name Algot Nelson

1178

Service No. ~~54~~ 786

Address 134 Gilbert St., Malden
30 Eaton

#7621

Location Lots 5+6 Eaton Rd

Kind of Pipe

Size

Size of Main

~~Repair - Renewal~~ - New Service

Location

Date	Material	Amount	Total	Date	Amount
	<i>Inside</i>				
	32' 1" C.L. Pipe @ .27	8 64			
	1 1" L.L. Coup.	25			
	1 1" L.L. Ell	35			
	1 1" Br. Sp. Nip.	30			
	1 S & W	3 00			
	Trucking	75	13 29		
10/28/30	53 Hrs. Labor @ .55	29 15			
	3 " " @ .60	1 80	30 95		
	15% Overhead		4 64		
	COST		13 29		
	Labor				
ARGE	33' @ 1.50	\$49 50	\$49 50		

Oct. 28 1930 - Cash 49 50

721-94

Outside:
Installed
16.6' - 3/4 Copper
1-3/4 Comp 3 pt. union
1-3/4 Comp. Curb
Box + Rod

Hadley Press, Inc. Lexington

25
8
33

DATE October 28, 1930

TOWN OF LEXINGTON—BOARD OF PUBLIC WORKS

WATER DIVISION

The undersigned applies for a supply of water at No. ^{#30} Lot 546, Eaton Road St. and hereby agrees to comply with the rules and regulations as now, or at any future time, established by the Board of Selectmen.

Am't. of Estimate \$ 49.50

Builder
Owner


Am't. Paid \$ 0.00

Address

Algot Nelson
134 Gilbert St
Malden
Mass

Owner
Builder A. Blanchard

Sketch of Service Here

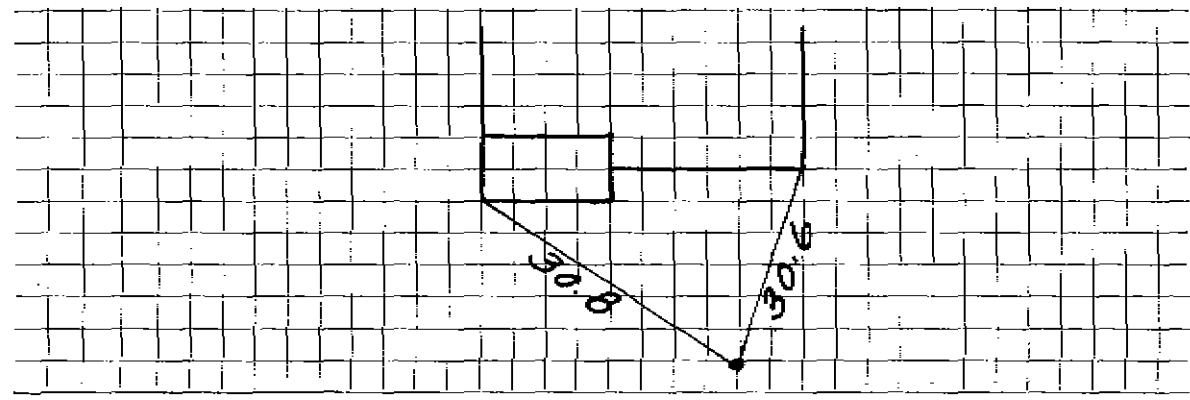

Connection made in _____ Street.

Work completed 7-21-94 19

Remarks: 3 part union 16.6 From Curb. 4' Past Gas main. Gas 3' deep