

WATER SERVICE RECORD

Name Telfer Const.

Service No. 156

Address 31 Eaton Road

2455

Location Lexington, Mass.

~~REPAIR~~ New Service Com 10-1-51


Date	Material	Amount	Total	Date	Material	Amount
8-11-51	Labor	1 49	1 49	7-12-51	Deposited	20 00
	10% Overhead		15	10-11-51	Paid	2 30
	65'-3/4" Copper Tubing @.326	21 19				27 30
	1-3/4"Cx1/2 I.W.H. S&W		4 00		No Charge	
	1-3/4"Cx3/4"C Union (3 pts)		1 72	8-11-51	Labor	1 49
	1 Hr. Trucking		75		10'-3/4" Copper Tubing @.326	3 26
			29 30		1-3/4"C Corp-Cock	1 33
					1-3/4"Cx3/4"C Curb-Cock	4 67
					1- Box & Rod	4 68
					1-1/2 Offset Tail Piece	50
					1-1/2 Straight Tail Piece	50
					1 Hr. Trucking	75
						20 18

DATE _____

TOWN OF LEXINGTON — BOARD OF PUBLIC WORKS

WATER DIVISION

Sketch of Service Here

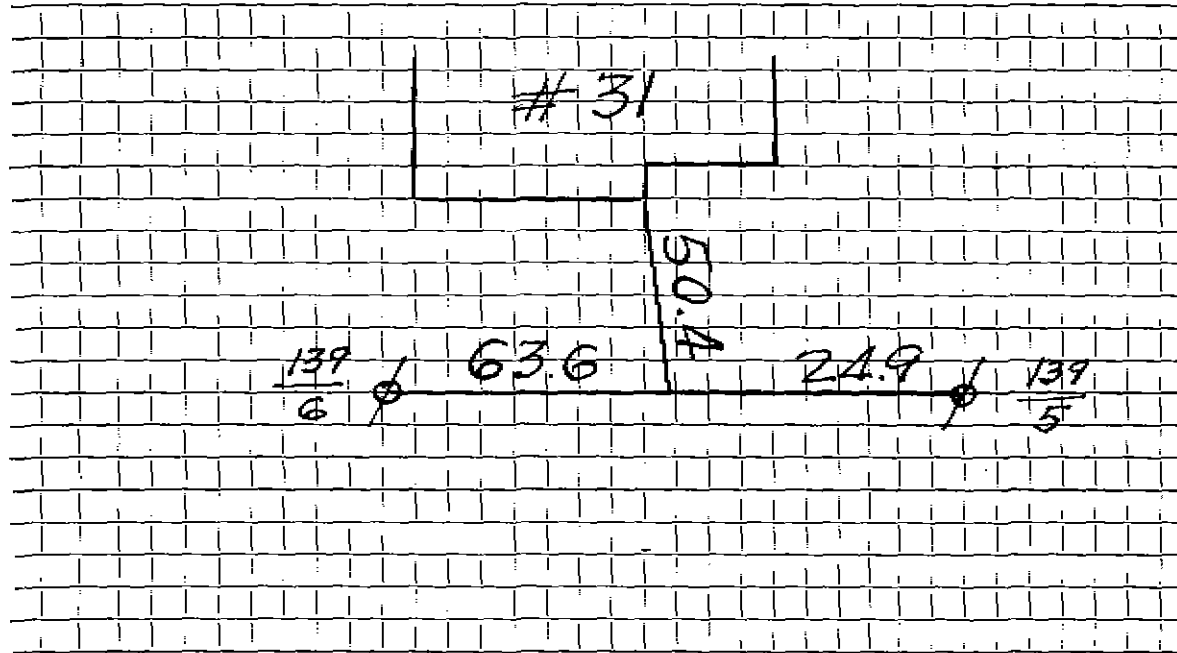

Connection made in Street. Work completed

Remarks:

.....

.....