

Name Iver Johnson

Service No.

124 #2367
#2368

Address 34 Eaton Road

Lexington, Mass.

Location 34 Eaton Road

Kind of Pipe

Size

Size of Main

~~Repair—Renewal—New Service~~

Com. 9-25-49

Location

Date	Material	Amount	Total	Date	Amount
Jul. 8, '49	Labor	17 15	17 15	July 8, '49	35 00
	10% Overhead		1 71	Oct 6, '49	2 82
	35' - 3/4" Copper Tubing @ .24	8 40		No Charge	32 18
	1 - 3/4" C x 1/2" I.W.H. S&W	3 29		1 - 1/2" Offset Tail Piece	37
	1 - 3/4" C x 3/4" I Union (2pts)	88		Jul, 8, '49 Labor	6 00
	Trucking 1 hr. @ .75	75			6 37
			32 18		
	Labor				

DATE _____

TOWN OF LEXINGTON - BOARD OF PUBLIC WORKS

WATER DIVISION

The undersigned applies for a supply of water at No..... St. and hereby agrees to comply with the rules and regulations as now, or at any future time, established by the Board of Selectmen.

Am't of Estimate \$.....

Owner


Am't Paid \$.....

Address

Builder

.....

Sketch of Service Here

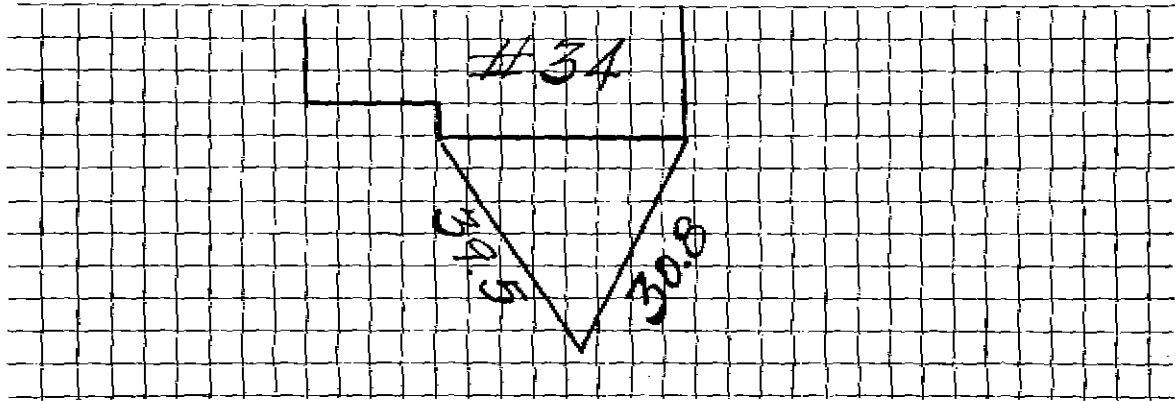

Connection made in Street.

Work completed19

Remarks: