

me William E. R. Coulton

Service No. 788

Address 45 Dudley Street, Medford  
35 Eaton

Location <sup>25 Eaton St</sup>  
Cor. Eaton & ~~Blake~~ Rds.

Kind of Pipe

Size

Size of Main

Repair—Renewal—New Service

Location

Date	Material	Amount	Total	Date	Amount
Mar. 21	4 hrs. Labor @ 55¢	2 20			
<i>Mar. 22</i>	2 " " @ 60¢	1 20	3 40	Jan. 16 1935 - Deposit	38 75
	10% Overhead on labor		34	June 19, 1935 - Returned	15 66
73	3/4" Copper Pipe @ 20¢		14 60		23 09
1	3/4" " Union		75		
1	S. & W.		2 75		
	Trucking 1 hr.		1 25		
			<u>23 09</u>		
	Labor				

Hadley Press, Inc., Lexington

Cor. Eaton & Blake Rds.

DATE January 7, 19

# TOWN OF LEXINGTON - BOARD OF PUBLIC WORKS

## WATER DIVISION

The undersigned applies for a supply of water at No. Block 24 } Lot 27, 28, 29 } West Manor St. and hereby agrees to comply with the rules and regulations as now, or at any future time, established by the Board of Selectmen.

Am't. of Estimate \$ 2.00

Owner

William E. R. Boulton


Am't. Paid \$ 36 <sup>75</sup>

Address

By William A. Price  
45 Dudley St.  
Medford, Mass.

Builder Same

Sketch of Service Here

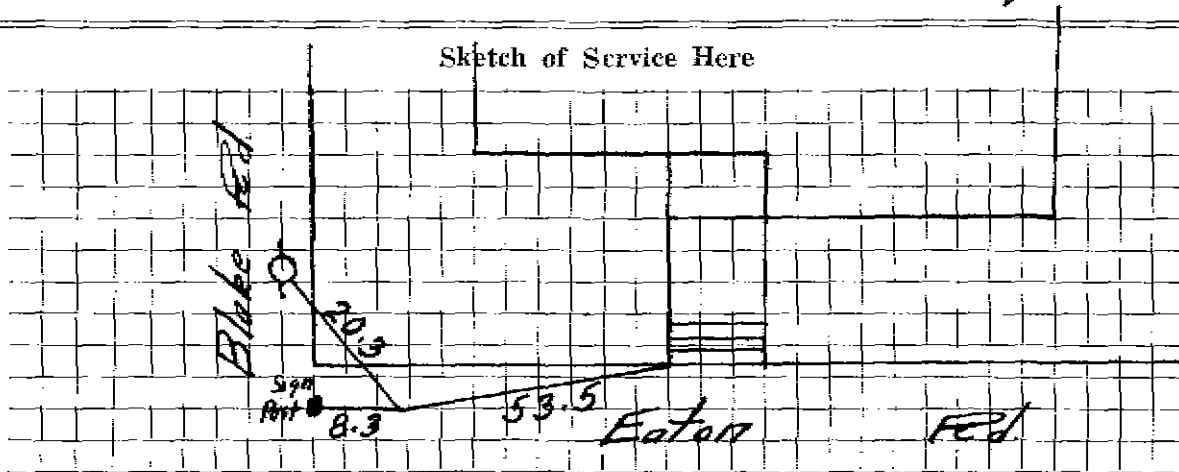

Connection made in \_\_\_\_\_ Street.

Work completed \_\_\_\_\_ 19

Remarks: