

Name R. W. Rogers

WATER SERVICE RECORD

#4401 F-3865
Service No. 167

Address 38 Eaton Rd.

Location Lexington

~~Repair~~—Renewal—~~XXXXXX~~ Service

Com. 11-3-52


Date	Material	Amount	Total	Date	Amount
9/25/52	Labor	1 63		7-52	Deposited 25 00
	10% Overhead	16	1 79	11-5-52	Refunded & credited 3 84
	43' - 3/4" Copper tubing @ .34	14 52			STREET WORK 21 16
	1 - 3/4" C x 1/2 I.W.H. stop & waste	4 00	9/25/52	Labor	1 63
	1 hr. trucking		75	26' - 3/4" Copper tubing @ .34	8 84
			21 16	1 - 3/4" C. Adapter	1 95
				1 - 3/4" C x 3/4" C. curb-cock	4 67
				1 box and rod	3 90
				1 - 1/2 offset tail piece	50
				1 - 1/2 straight tail piece	50
				1 hr. trucking	75
				patching 10 X 3	10 00
					32 74

DATE _____

TOWN OF LEXINGTON — BOARD OF PUBLIC WORKS

WATER DIVISION

Sketch of Service Here

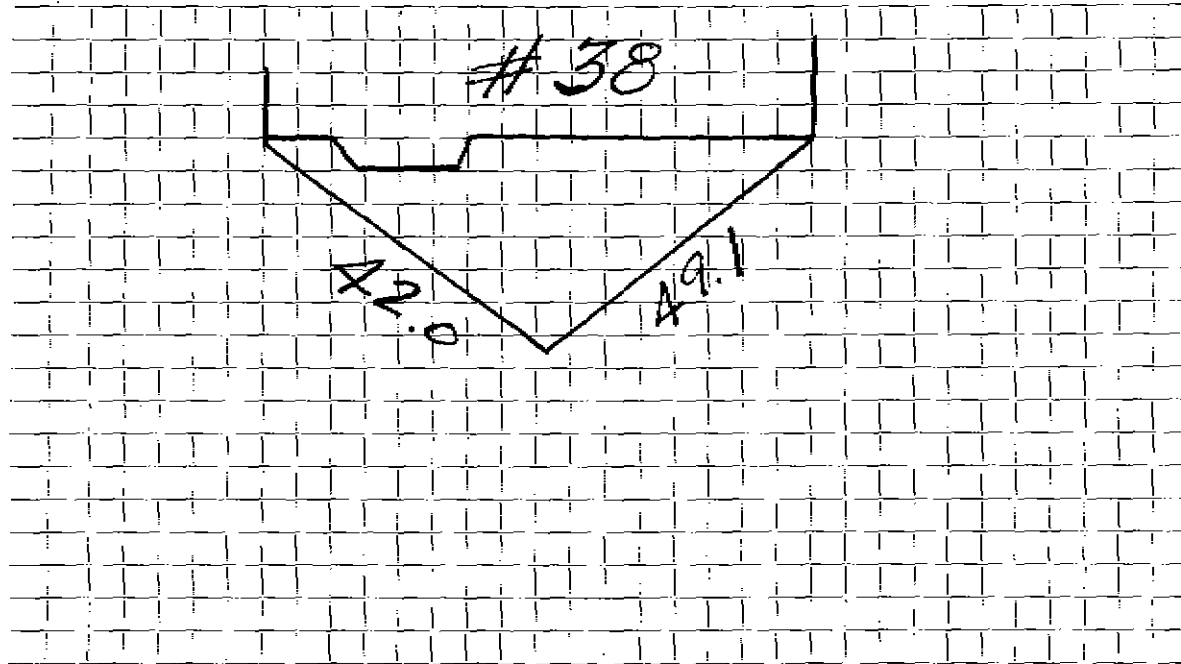

Connection made in Street. Work completed

Remarks: *Original 11-21-33*

.....
.....