

Name Alfred Nelson  
 Address 4 Eaton Road  
 Lexington, Mass.

Service No. 6

Location 4 Eaton Road

Kind of Pipe Size Size of Main

~~Repair~~ ~~Renewal~~ New Service Com. 2-21-49

Location

Date	Material	Amount	Total	Date	Amount
Jan. 10, '49	Labor	1 15	1 15	Jan 7, '49 Deposited	25 00
	10% Overhead		12	Feb 24/49 Refunded	7 00
	44' - 3/4" Copper Tubing @ .27	11 88	11 88	Non-Charge	17 05
	1 - 3/4" C x 1/2" I.W.S. S.W	3 15	3 15	Jan. 10, '49 Labor	1 15
	Trucking 1 hr.		75	20' - 3/4" Copper Tubing @ .27	5 40
			17 05	1 - 3/4" C Corp-cock	3 00
				1 - 3/4" C x 3/4" C Corp-cock	3 68
				1 - Box & Rod	3 55
				1 - 3/8" Offset Tail Piece	30
				1 - 3/8" Straight Tail Piece	30
				Littlefield Shovel 3 hrs. @ 7.00	21 00
				Trucking 1 hr.	75
	Labor				39 13

DATE \_\_\_\_\_

TOWN OF LEXINGTON - BOARD OF PUBLIC WORKS

**WATER DIVISION**

The undersigned applies for a supply of water at No..... St. and hereby agrees to comply with the rules and regulations as now, or at any future time, established by the Board of Selectmen.

Am't of Estimate \$.....

Owner .....


Am't Paid \$.....

Address .....

Builder .....

.....

Sketch of Service Here

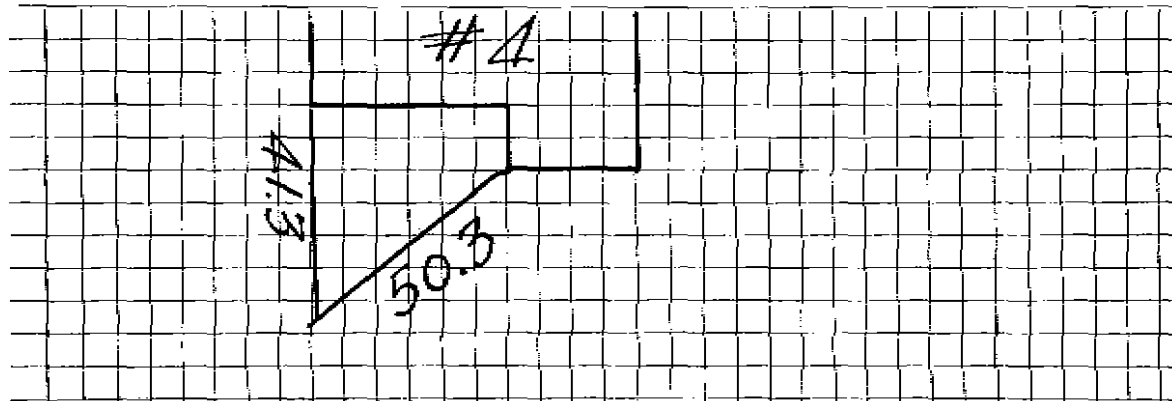

Connection made in ..... Street.

Work completed .....19

Remarks: