

WATER SERVICE RECORD

#6520

Name _____ Service No. _____

Address 11 Edgewood Road # 2462

Location _____

Repair - ~~Replace New Service~~ W.O. #260


Date	Material	Amount	Total	Date	Amount
5-5-65	Labor	101 31			
	10% O.H.	10 13	111 44		
	20' 1" Copper tubing @ .56		11 20		
	1 1" Corp		10 66		
	1 1" Curb Cock		11 15		
	1 1 1/4" Bushing		1 81		
	1 1 1/4" Coupling		86		
	18 x 3 Patch		18 00		
	1 6 x 12 Style 366 Sleeve				
	2 Hrs. Town Truck @ 3.00		6 00		
	3 Hrs. Loader @ 4.00		12 00		

DATE _____

TOWN OF LEXINGTON — BOARD OF PUBLIC WORKS
WATER DIVISION

Sketch of Service Here

11 EDGEWOOD

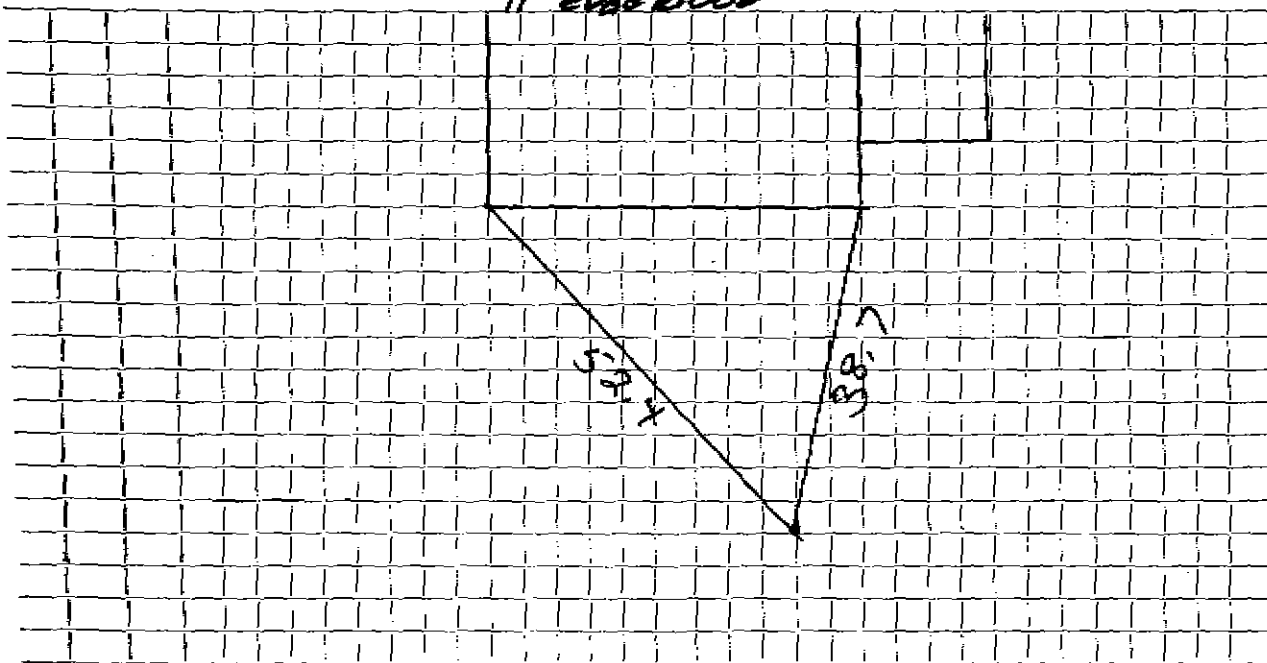

Connection made in Street. Work completed

Remarks:
.....
.....