

Name

Address

Service No.

791 #4322

Location

17 Edgewood Rd.

Kind of Pipe

Size

Size of Main

Repair—Renewal—New Service

Location

Date

Material

Amount

Total

Date

Amount

Labor

DATE _____

TOWN OF LEXINGTON—BOARD OF PUBLIC WORKS WATER DIVISION

The undersigned applies for a supply of water at No. _____ St. and hereby agrees to comply with the rules and regulations as now, or at any future time, established by the Board of Selectmen.

Am't. of Estimate \$ _____


Owner Tibbetts

Am't. Paid \$ _____

Address 17. Edgwood Rd.

Builder _____

Sketch of Service Here

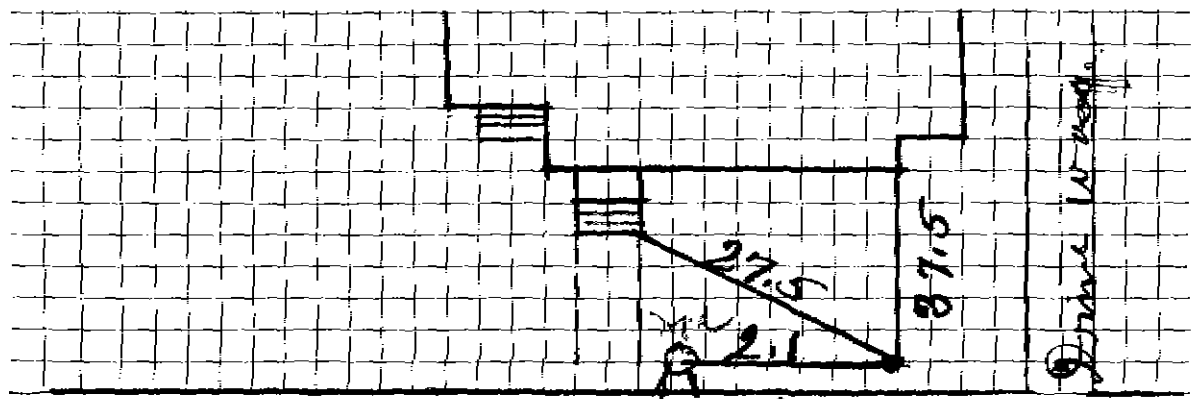

Connection made in Edgwood Street. Rd. Work completed _____ 19

Remarks: