

WATER SERVICE RECORD

Name *Steven Bradley*

Service No.

Address *18 EDGEWOOD RD*

Location


~~Repair~~ Renewal ~~XXXXXXX~~ ~~New Service~~ Valeri #3868

Date	Material	Amount	Total	Date	Amount
<i>Dec. '83</i>	<i>71'</i>	<i>1" Copper</i>			
		<i>1" Valve</i>			
					<i>OUTSIDE</i>
				<i>Dec. '83 17'</i>	<i>1" Copper</i>
					<i>1" Curb</i>
					<i>1" Corp.</i>
				<i>1</i>	<i>Box & Rod</i>

TOWN OF LEXINGTON — BOARD OF PUBLIC WORKS

WATER DIVISION

Sketch of Service Here

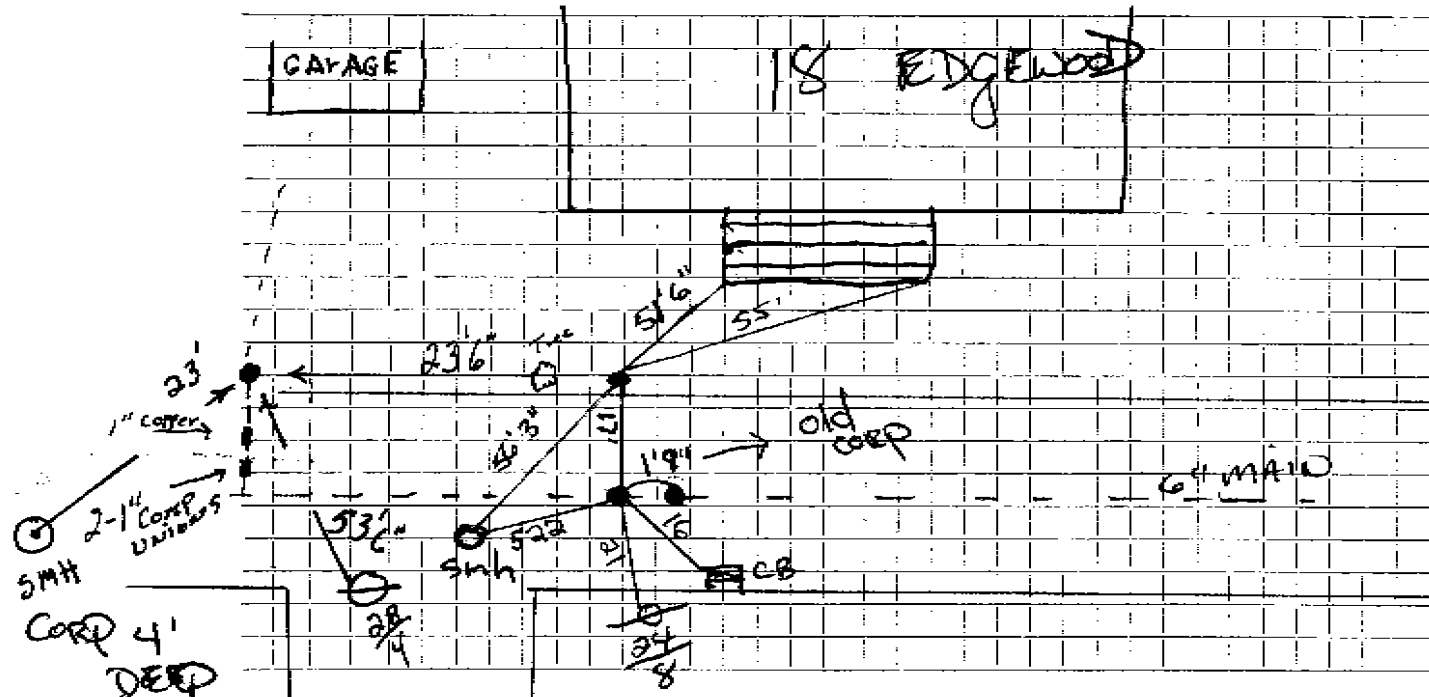

Connection made in Street: Work completed

Remarks: