

WATER SERVICE RECORD

Name Ronald D. Brown

Service No. 8

Address 27 Edgewood Road

# 1649

Location

~~REPAIR~~ - Renewal - ~~WATER SERVICE~~ W.O. # 6062

MAY 27 1969

Date	Material	Amount	Total	Date	Amount
4/24/69	Labor	99 54		3-17-69	500 08
	10% O.H.	9 95	109 49	5-22-69	225 35
	86'-Copperpipe .79		67 94		OUTSIDE 274 65
1-	3/4" Wheel Valve		9 30	4/24/69	Labor 33 18
2-	3/4" Unions 1.81		3 62	5/5/69	34 52
1-	3/4" Brass Coupling		3 00	5/6/69	6 21
2	Hrs. Trucking 3.00		6 00	10-	3/4" Copper pipe .79 7 90
4	" Shovel 6.50		26 00	1-	3/4" Curb Cock 11 32
			225 35	1-	3/4" Adaptor 2 76
				2 1/2	Ton hot top 5.80 13 85
				3 1/2	Hrs. trucking 3.00 10 50
				1/2	" " 1.50 75
				1	" shovel 6 50
				1/2	" compressor 5.00 2 50
				1	" roller 3 00
					tractor 5 00
					137 19


TOWN OF LEXINGTON - BOARD OF PUBLIC WORKS

### WATER DIVISION

DATE \_\_\_\_\_

Sketch of Service Here

27 EDGEWOOD

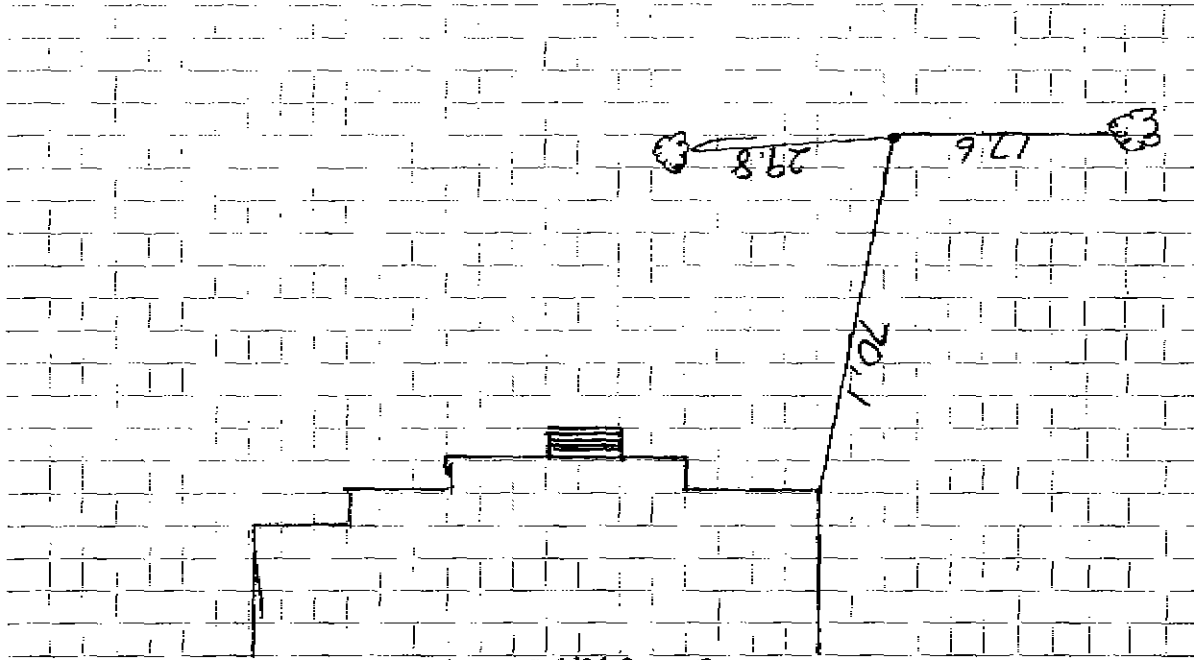

Work completed \_\_\_\_\_

Street \_\_\_\_\_

Connection made in \_\_\_\_\_

Remarks: \_\_\_\_\_